County: Franklin

Permit #:

Driller: Gary Rayborn

Date drilling completed: 7-28-15

STATE WELL REPORT

Part 1

Driller's Log

Mississippi Department of Environmental Quality
Office of Land and Water Resources
P.O. Box 2309
Jackson, MS 39225-2309
(601)961-5210
(601)360-0535 (fax)

For Office Use Only:

Well #: A 19

Aquifer:

E-Log #:

State Law requires that this report be prepared by the license holder responsible for the work and filed with the Department at the above address within 30 days of completion of drilling of the well or borehole.

Well Owner Information
(Landowner if borehole is not for a water well)

Owner Name: Scotty Godchaux

Mailing Address: 282 James St

Sunset LA 71584
City State Zip Code

Telephone No. (337) 945-5123

Well or Borehole Location 31° 31' 40" 91° 09' 09"

Latitude: 31.528014 Longitude: -91.151249

Method of Lat/Long (*check one*): Conventional Survey____, USGS quad____, Hand-held GPS____, Survey-grade GPS____

NE ¼ NW ¼, Sec 48 T 7N R 1E

4.5 Miles W/NW of Roxie
(*Distance*) (*Direction*) (*Nearest Town*)

Well / Borehole Data

Date drilling started: 7-27-15 Date drilling completed: 7-28-15 Hole depth: 110' Hole diameter: 4"

Location of the source of any surface water used for drilling: —

Method of dosing and volume of Chlorine used in drilling and development: —

Logs run (*circle all applicable*): [No log run] Electric Gamma Ray Density Sonic Neutron Other:

Name of organization running log(s): —

Purpose of borehole (*circle one*): [Water Well] Geotechnical/Geological Investigation Ground Source Heat Pump Seismic Survey Other (*describe*)

If drilling is not related to water well construction, skip the remainder of this block

Purpose of Well (*circle all applicable*): [Home] Industrial Public Supply Irrigation Fish Culture

Other (*describe*):

If a flowing well, method of flow regulation: Valve Other (*describe*)

Static Water Level: 55' feet [above or (below)] land surface (*circle one*) Date measured: 7-28-15

Method of measurement (*circle one*): Steel tape [Electric tape] Air line Other (*describe*):

Well depth: 110' Well grouted to a depth of: 10 feet Type of grout (*circle one*): [Neat Cement] Bentonite Mix

Casing length: 90 feet Casing diameter: 4 inches Type of casing: PVC

Screen length: 20 feet Screen diameter: 4 inches Type of screen: PVC

Screen slot size: .010 inches Setting depth: From 90 feet to 110 feet

Type of completion (*circle all applicable*): [Gravel packed] Underreamed Open hole Natural Development

Other (*describe*): —

Top of lap pipe or reduction in casing: — feet

If telescoped or more than one screen, describe on next page

RECEIVED
AUG 06 2015
BY: OLWR

County: Franklin

Permit #: _____

For Office Use Only:

Well #: _____

The sketch below only required for water wells

If well telescopes, show depths on sketch.

Ground Level

If more than one screen, show location of each on sketch

Description of formations encountered must be provided for all wells and boreholes, unless specifically exempted by regulations

Description of Formations Encountered	From (depth)	To (depth)
Chalk	Ground level	45
Coarse Sand	45	110

Sketch the property layout and include the following:

1) the well location
2) any permanent structures on the property that may aid in locating the well
3) any roads, power lines, or other items that may aid in locating the property and the well
4) north arrow

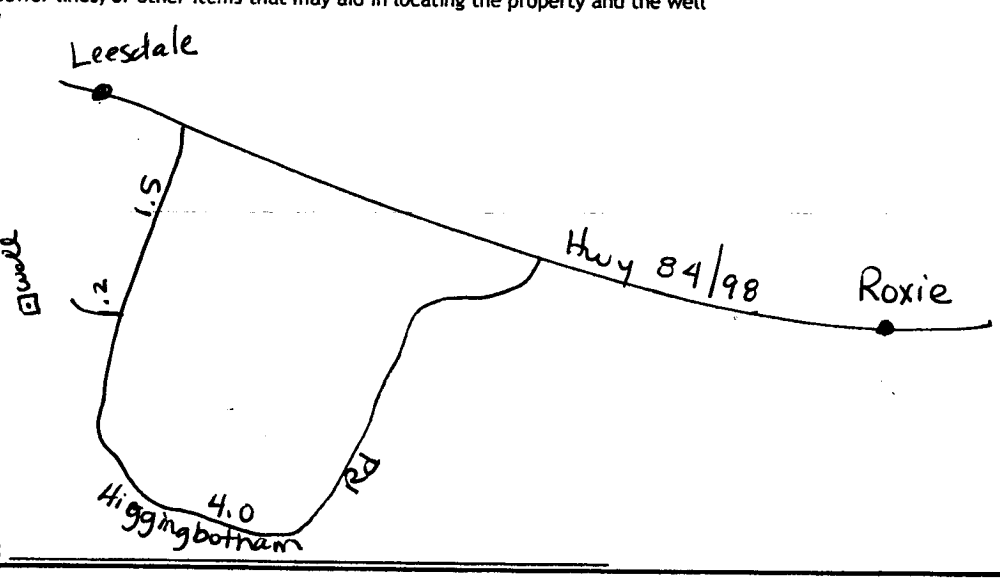

Landowner Name: _____

I HEREBY CERTIFY that the well/borehole was drilled, constructed, and completed in accordance with all applicable requirements of the Mississippi Department of Environmental Quality and the Mississippi Department of Health regulations, if applicable, and state laws.

Rayborn Drilling, Inc. O-60 — Print Name of Responsible Licensee and License No.

8/5/15 — Date

Signature of Licensee

Form: OLWR-SWR-1A (4/13)

STATE WELL REPORT

County: Franklin
Permit #:
Driller: Gary Rayborn
Date completed: 7-28-15
Copy information from block on Part 1

Part 2
Pump Installer's Completion Report

Mississippi Department of Environmental Quality
Office of Land and Water Resources
P.O. Box 2309
Jackson, MS 39225-2309
(601)961-5210
(601) 360-0535 (fax)

For Office Use Only:
Well #: A 19
Aquifer:

This part of the report must be completed by a licensed water well contractor or a licensed pump installer. A copy of Part 1 of the report must be attached and both parts filed with the Department at the above address within 30 days of well completion.

Well Owner Information

Owner Name: Scotty Godchaux
Mailing Address: 282 James St.
Sunset (City) LA (State) 71584 (Zip Code)
Telephone No. (337) 945-5123

Well Location

Latitude: 31.528014 Longitude: -91.151249
Method of Lat/Long (*check one*): Conventional Survey____, USGS quad____, Hand-held GPS____, Survey-grade GPS____
____ ¼ ____ ¼, Sec 48 T 7N R 1E
4.5 (*Distance*) Miles W/NW (*Direction*) of Roxie (*Nearest Town*)

Pump Type (*circle one*)

Submersible Turbine Air Lift Centrifugal Flowing Well Jet Piston Rotary Other (*describe*):
Date Pump Installed: 7-28-15 Rated Pump Capacity: 10 Gallons Per Minute
Is This Pump (*circle one*): New Repaired Replacement

Power Type (*circle one*)

Electric Diesel Gasoline Natural Gas Tractor PTO Windmill Other (*describe*):
Horse Power Rating of Motor: 1 Setting Depth: 90 feet Number of Stages: 11

Pump Test Data for Non Flowing Well

Date Well Tested: 7-28-15 Duration of Pump Test (*minimum 4 hours*): — hours
Static Water Level (A): 55 Feet Below Land Surface Pumping Water Level (B): — Feet Below Land Surface
Drawdown [(B) - (A)]: — Feet Below Land Surface Test Pumping Rate: 10 Gallons Per Minute
Method of measurement (*circle one*): Steel tape Electric tape Air line Other (*describe*):

Pump Test Data for Flowing Well

Measured shut in head: ____ feet.
Well yielded ____ GPM with a drawdown of ____ feet after ____ hours of pumping

Meter Installation

Meter Manufacturer: Meter Serial Number:
Meter Model Number/Name: Type of Meter:
Totalizer Register Unit and Multiplier Factor (AF x .001, gal x 1000, etc):
Installation Date: Meter installed by:
Is This Meter (*circle one*): New Repaired Replacement

Important: By submitting the above information you are certifying that this meter was installed to manufacturer standards. For agricultural wells, a list of approved meters is on the MDEQ website.

I HEREBY CERTIFY that the above statements are true to the best of my knowledge.

Rayborn Drilling, Inc. 0-60 8/5/15
Print Name of Pump Installer and License No. (*if applicable*) Date Signature of Pump Installer

RECEIVED AUG 06 2015 BY: OLWR

Form: OLWR-SWR-1B (4/13)