31.17278 -88.67 (from elog)

200

Greene
K27
6/10/79
Elog #118

MISSISSIPPI
BOARD OF WATER COMMISSIONERS
416 North State Street
Jackson, Mississippi 39201

CODE:

WATER WELL DRILLERS LOG

6-10-79 19 HOLLAND WELL CO Green
date well completed | firm name | county well located

LANDOWNER: Beat III Green County Water Association
Rt. 1, Richton Miss
(mailing address)

WELL LOCATION:
SW/SW sec. 3 35 T 2 N & R 7 E W
10 miles (distance) N.W. (direction) of Leakesville (nearest town)

WELL PURPOSE: (home, irrigation, municipal, industrial)

WELL COMPLETION DATA:

(1) diameter (inches) 6"

(2) total depth (feet) 240'

(3) static water level (feet) 66' below above top of ground.

(4) casing Steel (material), 210' (depth), 4" (size) if telescope see back.

(5) screen 30' (length), 190' (depth to top), 4" (size), S. Steel (material)

(6) pump 10 (HP) 110 (yield gpm)
Electric (type power)

(7) electric log Yes (yes or no)
State Miss. (organization running log)

(8) how well bottom plugged Value

DRILLERS REMARKS:
Unity

description of formations encountered	from	to
Clay	0	20
Clay	20	40
Clay	40	60
Clay	60	80
Clay Hard Blue	80	100
Clay Sand Streks	100	120
Clay Hard Blue	120	140
Clay Hard	140	160
Clay "	160	180
Sand Clay Streks	180	200
Clay	200	210
Sand	210	220
Sand	220	240
Sand Hard Clay Bottom	240	244

Miss. Board of Water Comm.:

JUN 25 1979

RECEIVED

If well telescopes please sketch and show depths.

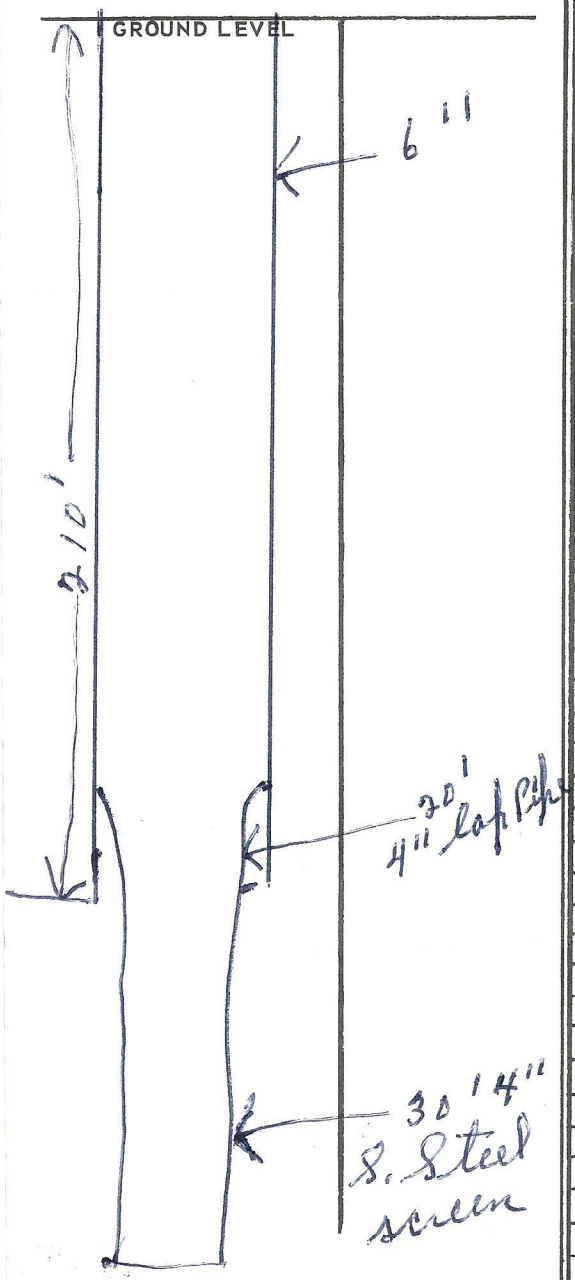

If more than one screen, show locations of each on sketch.

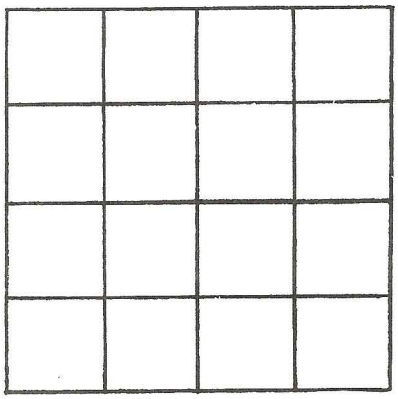

SECTION 3

Please indicate well location X.

ADDITIONAL INFORMATION