S-17

| Description of Formations Encountered | | |
|---|---|---|
| sand | 0 | 45 |
| sand & clay | 45 | 75 |
| Blue clay | 75 | 104 |
| sand & gravel | 104 | 145 |

If more than one screen, show location of each on sketch

Sketch the property layout and include the following: 1) the well location; 2) any permanent structures on the property that may aid in locating the well; 3) any roads, power lines, or other items that may aid in locating the property and the well; 4) indicate direction.

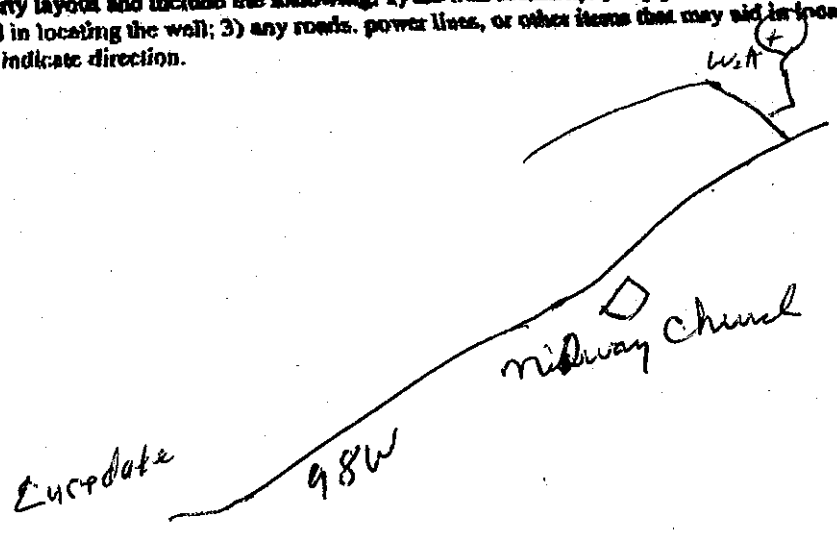


Landowner Name: Wendle Pitts

Michael R Trufogle 0408
Signature of Water Well Contractor

RECEIVED
JUN 27 2007
BY: OLWR