Greene

STATE WELL REPORT

Part 1

Driller's Log

Mississippi Department of Environmental Quality
Office of Land and Water Resources
P.O. Box 2309
Jackson, MS 39225-2309
(601)961-5555
(601)961-5228 (fax)

184

County: George
Permit #:
Driller: Michael Fryfogle
Date drilling completed: 08/22/2021

For Office Use Only:
Well #: T 90
Aquifer:
E-Log #:

State Law requires that this report be prepared by the license holder responsible for the work and filed with the Department at the above address within 30 days of completion of drilling of the well or borehole.

Well Owner Information
(Landowner if borehole is not for a water well)

Owner Name: Chason Anderson
Mailing Address: 1812 Allen Rd

Lucedale | Ms | 39452
City | State | Zip Code

Telephone No. (____) ____

Well or Borehole Location

Latitude: 31.0013700 Longitude: -88.6088590

Method of Lat/Long (*check one*): Conventional Survey____, USGS quad____, Hand-held GPS☑, Survey-grade GPS____

SW ¼ SE ¼, Sec 32 T 1N R 6W

5.32 Miles (*Distance*) SE (*Direction*) of Lucedale (*Nearest Town*)

Well / Borehole Data

Date drilling started: 08/22/2021 Date drilling completed: 08/22/2021 Hole depth: 100 Hole diameter: 4 1/2

Location of the source of any surface water used for drilling: None

Method of dosing and volume of Chlorine used in drilling and development:

Logs run (check *all applicable*): No log run☑ Electric Gamma Ray Density Sonic Neutron Other:

Name of organization running log(s):

Purpose of borehole (check one): Water Well ☑ Geotechnical/Geological Investigation Ground Source Heat Pump Seismic Survey Other (*describe*)

If drilling is not related to water well construction, skip the remainder of this block

Purpose of Well (check *all applicable*): Home☑ Industrial Public Supply Irrigation Fish Culture

Other (*describe*):

If a flowing well, method of flow regulation: Valve ____ Other (*describe*)

Static Water Level: 60 feet [above or ☑below] land surface (check *one*) Date measured: 08/22/2021

Method of measurement (check *one*): Steel tape Electric tape Air line☑ Other (*describe*):

Well depth:____ Well grouted to a depth of:____ feet Type of grout (check *one*): Neat Cement Bentonite☑ Mix

Casing length: 90 feet Casing diameter: 2 inches Type of casing: Sch40

Screen length: 10 feet Screen diameter: 2 inches Type of screen: Wrap

Screen slot size: .06 inches Setting depth: From 90 feet to 100 feet

Type of completion (check *all applicable*): Gravel packed☑ Underreamed Open hole Natural Development

Other (*describe*):

Top of lap pipe or reduction in casing: ____feet

If telescoped or more than one screen, describe on next page

RECEIVED
AUG 24 2021
BY OLWR

Form: OLWR-SWR-1A (*4/13*)

County: George

Permit #: _____

For Office Use Only:

Well #: _____

The sketch below only required for water wells

If well telescopes, show depths on sketch.

Ground Level

If more than one screen, show location of each on sketch

Description of formations encountered must be provided for all wells and boreholes, unless specifically exempted by regulations

Description of Formations Encountered	From (*depth*)	To (*depth*)
Mix	Ground level	15
Sand	15	22
Blue clay	22	88
Sand	88	100

RECEIVED
AUG 2 6 2021
BY OLWR

Sketch the property layout and include the following:

1) the well location
2) any permanent structures on the property that may aid in locating the well
3) any roads, power lines, or other items that may aid in locating the property and the well
4) north arrow

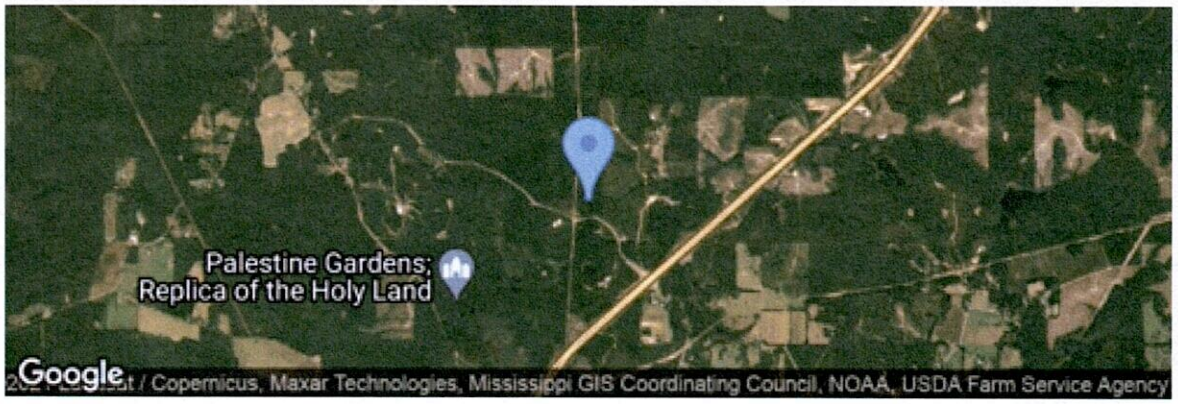

Landowner Name: Chason Anderson

I HEREBY CERTIFY that the well/borehole was drilled, constructed, and completed in accordance with all applicable requirements of the Mississippi Department of Environmental Quality and the Mississippi Department of Health regulations, if applicable, and state laws.

Michaël Fryfogle 0408	08/23/2021	Michael Fryfogle
Print Name of Responsible Licensee and License No.	Date	Signature of Licensee

Form: OLWR-SWR-1B (*4/13*)