MISSISSIPPI DEPARTMENT OF NATURAL RESOURCES

Bureau of Land and Water Resources

P.O. Box 10631
Jackson, Mississippi 39209

WATER WELL DRILLERS LOG

COUNTY WELL LOCATED: Hancock

WELL NUMBER: A 2048 | CODED:

DATE WELL COMPLETED: 4-25-88

PERMIT NUMBER:

NAME OF DRILLING FIRM: POUNCEY WATER WELL DRILLING
ROUTE 3, BOX 461
PICAYUNE, MS. 39466

NAME & MAILING ADDRESS OF LANDOWNER
R.T. Taylor
Rt 3 Leetown

WELL LOCATION: SEC 32 TOWNSHIP 5 N/S RANGE 15 E/W

DISTANCE 3/4 Miles DIRECTION N of NEAREST TOWN Lewis Spur

OTHER LANDMARK On Leetown Rd.

WELL PURPOSE: Home, Irrigation, Municipal, Industrial, Fish Pond, etc.

PUMP DATA

PUMP TYPE (Circle One): Submersible, Turbine, Jet, Flowing Well, Other (Describe) _____

POWER TYPE (Circle One): Electric, Tractor, Diesel, Gasoline, Butane, Other (Describe) _____

Pump Capacity (GPM)	No. of Stages	Setting Depth
12 8	2	100 FT.

PUMP TEST

Well yielded 10 GPM with a drawdown of _____ ft. after _____ hours of pumping

WELL DATA

Well Depth	Casing Diameter (In.)	Casing Length (Ft.)
444	2	429

Type of Casing	Hole Depth	Depth to Static Water Level
PVC	444	86 1

TYPE OF COMPLETION: (Circle One or More): Gravel Packed, Underreamed, Telescoped, ~~Natural Development~~, Open Hole, Other (Describe) _____

Top of Lap Pipe or Reduction in Casing FEET

IF TELESCOPED OR MORE THAN ONE SCREEN: USE BACK PAGE

LOG DATA

TYPE OF LOG RUN (Circle One): No Log Run, Electric, Gamma Ray, Density, Sonic, Neutron, Other (Describe) _____

Name of Organization Running Log

GEOLOGIC DATA (Office Use Only)

Surface Elev.	Geologic Unit	Unit Thickness	Depth to Top
Subs. SWL	Date	Analysis	Aquifer Test

Driller's Remarks

SCREEN DATA

Diameter - Inches	Length - Feet	Slot Size - Inches
2	15	5 088 10-010

Screen Type	Depth to Bottom - Feet
PVC wrap.	444

RECEIVED
MAY 16 1988
Department of Natural Resources
Bureau of Land & Water Resources

DESCRIPTION OF FORMATIONS ENCOUNTERED	FROM	TO
Top	0	36
Sd wt Big gravel	36	70
Clay	70	218
Sd.	218	260
Clay	260	376
St & Sd -	376	444

FORMATIONS (Continued)	FROM	TO

IF MORE SPACE IS NEEDED, USE BACK

If well telescopes please
sketch and show depths.

GROUND LEVEL

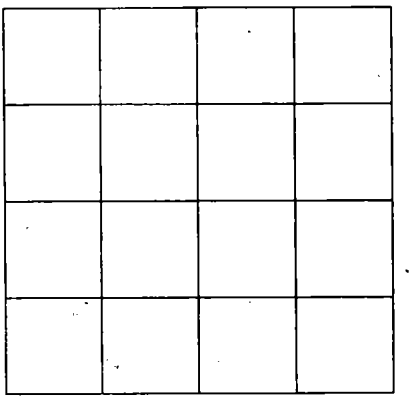

SECTION _____

Please indicate well location X.

ADDITIONAL INFORMATION

If more than one screen,
show location of each on sketch.