MISSISSIPPI DEPARTMENT OF NATURAL RESOURCES

Bureau of Land and Water Resources

P.O. Box 10631
Jackson, Mississippi 39209
WATER WELL DRILLERS LOG

COUNTY WELL LOCATED: Hancock	
WELL NUMBER: A2046 CODED	PERMIT NUMBER:
	NAME OF DRILLING FIRM: Pouncy
DATE WELL COMPLETED: 2-10-89	

NAME & MAILING ADDRESS OF LANDOWNER: Robert Gilmore, Eugene Lodmer Rd.

WELL LOCATION: SEC 25 TOWNSHIP 5 N/S RANGE 15 E/W

DISTANCE 2 1/4 Miles DIRECTION West of NEAREST TOWN Necaw

OTHER LANDMARK: 2nd House Right Eugene Rd

WELL PURPOSE: Home, Irrigation, Municipal, Industrial, Fish Pond, etc.

PUMP DATA

PUMP TYPE (Circle One): Submersible, Turbine, Jet, Flowing Well, Other (Describe)

POWER TYPE (Circle One): Electric, Tractor, Diesel, Gasoline, Butane, Other (Describe)

Pump Capacity (GPM)	No. of Stages	Setting Depth
14	9	120 FT.

PUMP TEST

Well yielded 14 GPM with a drawdown of — ft. after — hours of pumping

WELL DATA

Well Depth	Casing Diameter (In.)	Casing Length (Ft.)
412	4X2	397

Type of Casing	Hole Depth	Depth to Static Water Level
PVC	6X5	78

TYPE OF COMPLETION: (Circle One or More): Gravel Packed, Underreamed, Telescoped, Natural Development, Open Hole, Other (Describe)

Top of Lap Pipe or Reduction in Casing: 160' 4" FEET

IF TELESCOPED OR MORE THAN ONE SCREEN: USE BACK PAGE

LOG DATA

TYPE OF LOG RUN (Circle One): No Log Run, Electric, Gamma Ray, Density, Sonic, Neutron, Other (Describe)

Name of Organization Running Log

GEOLOGIC DATA (Office Use Only)

Surface Elev.	Geologic Unit	Unit Thickness	Depth to Top
Subs. Swl	Date	Analysis	Aquifer Test

Driller's Remarks: Hard to produce

RECEIVED
MAY 25 1989
Department of Natural Resources
Bureau of Land & Water Resources

SCREEN DATA

Diameter - Inches	Length - Feet	Slot Size - Inches
2	15	010

Screen Type	Depth to Bottom - Feet
PVC	412

DESCRIPTION OF FORMATIONS ENCOUNTERED	FROM	TO
Top	0	18
Sd Sd.	18	46
Beige to Blue	46	204
Sd.	204	232
Blue	232	350

FORMATIONS (Continued)	FROM	TO
Sd.	350	396
fine Sd.	396	412

IF MORE SPACE IS NEEDED, USE BACK

If well telescopes please
sketch and show depths.

GROUND LEVEL

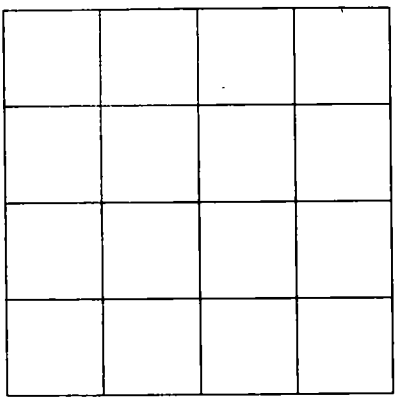

SECTION _____

Please indicate well location X.

ADDITIONAL INFORMATION

If more than one screen,
show location of each on sketch.