MISSISSIPPI DEPARTMENT OF NATURAL RESOURCES

Bureau of Land and Water Resources

P.O. Box 10631
Jackson, Mississippi 39209

WATER WELL DRILLERS LOG

COUNTY WELL LOCATED: Hancock	
WELL NUMBER: C1089	CODED:
DATE WELL COMPLETED: 3-10-89	
PERMIT NUMBER:	
NAME OF DRILLING FIRM: Pouvey	

NAME & MAILING ADDRESS OF LANDOWNER: Tony Cantin, Burnville Rd., E. Wy.

WELL LOCATION: SEC 18 TOWNSHIP 6 N/S RANGE 15 E/W

DISTANCE 4 Miles DIRECTION South of NEAREST TOWN Sal.

OTHER LANDMARK: New Country Store

WELL PURPOSE: Home, Irrigation, Municipal, Industrial, Fish Pond, etc. Country Store

PUMP DATA

PUMP TYPE (Circle One): Submersible, Turbine, Jet, Flowing Well, Other (Describe) _____

POWER TYPE (Circle One): Electric, Tractor, Diesel, Gasoline, Butane, Other (Describe) _____

Pump Capacity (GPM)	No. of Stages	Setting Depth
		FT.

PUMP TEST

Well yielded _____ GPM with a drawdown of _____ ft. after _____ hours of pumping

WELL DATA

Well Depth	Casing Diameter (In.)	Casing Length (Ft.)
58	2	53

Type of Casing	Hole Depth	Depth to Static Water Level
PVC	58	26'

TYPE OF COMPLETION: (Circle One or More): Gravel Packed, Underreamed, Telescoped, Natural Development, Open Hole, Other (Describe) _____

Top of Lap Pipe or Reduction in Casing: FEET

IF TELESCOPED OR MORE THAN ONE SCREEN: USE BACK PAGE

LOG DATA

TYPE OF LOG RUN (Circle One): No Log Run, Electric, Gamma Ray, Density, Sonic, Neutron, Other (Describe) _____

Name of Organization Running Log

GEOLOGIC DATA (Office Use Only)

Surface Elev.	Geologic Unit	Unit Thickness	Depth to Top
Subs. SWL	Perm.	Aquifer	Aquifer Test

Driller's Remarks: Owner installed Fes. com. pump

RECEIVED
MAY 25 1989
Department of Natural Resources
Bureau of Land & Water Resources

SCREEN DATA

Diameter - Inches	Length - Feet	Slot Size - Inches
2	5	010

Screen Type	Depth to Bottom - Feet
PVC	58

DESCRIPTION OF FORMATIONS ENCOUNTERED	FROM	TO	FORMATIONS (Continued)	FROM	TO
Top	0	8			
Clay	8	16			
Sand	16	50			
			IF MORE SPACE IS NEEDED, USE BACK		

If well telescopes please sketch and show depths.

GROUND LEVEL

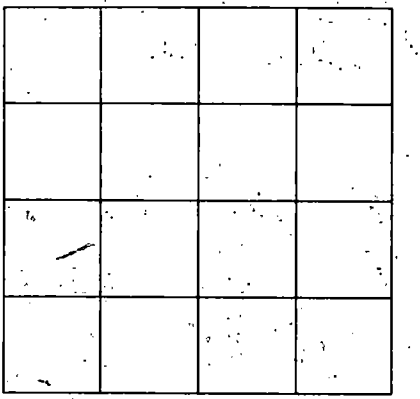

SECTION _____

Please indicate well location X.

ADDITIONAL INFORMATION

If more than one screen, show location of each on sketch.