MISSISSIPPI DEPARTMENT OF NATURAL RESOURCES
Bureau of Land and Water Resources

P.O. Box 10631
Jackson, Mississippi 39209
WATER WELL DRILLERS LOG

COUNTY WELL LOCATED: Hancock
WELL NUMBER: C-3 ~~CODED~~
2101
DATE WELL COMPLETED: 12-10-91

PERMIT NUMBER:
NAME OF DRILLING FIRM: Pourney

NAME & MAILING ADDRESS OF LANDOWNER
Milton Murrin
North Brenville Rd
Pearl

WELL LOCATION: SEC 18 TOWNSHIP 6 (N/S) RANGE 15 (E/W)

DISTANCE 3 Miles DIRECTION N of NEAREST TOWN Brenville Church

OTHER LANDMARK: North end North Brenville

WELL PURPOSE: (Home), Irrigation, Municipal, Industrial, Fish Pond, etc.

PUMP DATA

PUMP TYPE (Circle One): Submersible, Turbine, (Jet), Flowing Well, Other (Describe) ____

POWER TYPE (Circle One): ~~Electric~~, Tractor, Diesel, Gasoline, Butane, Other (Describe) ____ H/P ____

Pump Capacity (GPM)	No. of Stages	Setting Depth
10	2	60 FT.

PUMP TEST

Well yielded 10 GPM with a drawdown of ____ ft. after ____ hours of pumping

WELL DATA

Well Depth	Casing Diameter (In.)	Casing Length (Ft.)
490	2	480

Type of Casing	Hole Depth	Depth to Static Water Level
PVC	490	42'

TYPE OF COMPLETION: (Circle One or More): Gravel Packed, Underreamed, Telescoped, (Natural Development), Open Hole, Other (Describe) ____

Top of Lap Pipe or Reduction in Casing FEET

IF TELESCOPED OR MORE THAN ONE SCREEN: USE BACK PAGE

LOG DATA

TYPE OF LOG RUN (Circle One): No Log Run, Electric, Gamma Ray, Density, Sonic, Neutron, Other (Describe) ____

Name of Organization Running Log

GEOLOGIC DATA (Office Use Only)

Surface Elev.	Geologic Unit	Unit Thickness	Depth to Top
Subs. SWL	Date	Analysis	Aquifer Test

Driller's Remarks

SCREEN DATA

Diameter - Inches	Length - Feet	Slot Size - Inches
2	10	008

Screen Type	Depth to Bottom - Feet
Wrap	490'

RECEIVED
JAN 13 1992
Dept. of Environmental Quality
Bureau of Land & Water Resources

DESCRIPTION OF FORMATIONS ENCOUNTERED	FROM	TO
Top	0	12
Sand gravel	12	105
Sand medium	105	186
Hard	186	367
Very fine wet sand	367	385
Sand clay shale	385	465
fine sand	465	490

FORMATIONS ENCOUNTERED	FROM	TO

IF MORE SPACE IS NEEDED, USE BACK

If well telescopes please sketch and show depths.

GROUND LEVEL

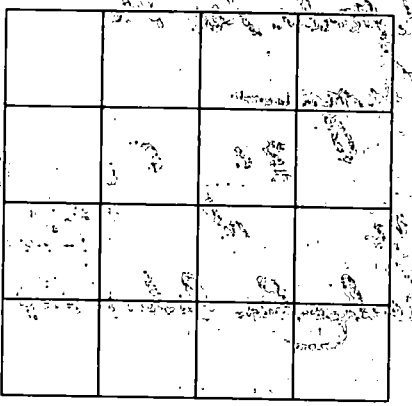

SECTION

Please indicate well location X.

ADDITIONAL INFORMATION

If more than one screen, show location of each on sketch.