MISSISSIPPI DEPARTMENT OF ENVIRONMENTAL QUALITY
Office of Land and Water Resources

P. O. Box 10631
Jackson, MS 39289-0631
WATER WELL DRILLERS LOG

COUNTY WELL LOCATED	Hancock
WELL NUMBER	C 2107
CODED	
DATE WELL COMPLETED	10-25-93
PERMIT NUMBER	0-561
NAME OF DRILLER	Bud Penton Water Well Service 778 Burgetown Rd. Carriere, MS 39426

NAME & MAILING ADDRESS OF LANDOWNER
Tommy Whitfield
P.O. Box 285
Carriere Ms 39426

WELL LOCATION: SEC	TOWNSHIP	RANGE
21	9 S	14 E

DISTANCE	DIRECTION	NEAREST TOWN
1 Miles	N of	Waveland

OTHER LANDMARK

WELL PURPOSE: Home, Irrigation, Municipal, Industrial, Fish Pond, etc.
Home

PUMP DATA

PUMP TYPE (Circle One): Submersible, Turbine, (Jet) Flowing Well, Other (Describe) _____

POWER TYPE (Circle One): (Electric) Tractor, Diesel, Gasoline, Butane, Other (Describe) _____ H/P 1/2

Pump Capacity (GPM)	No. of Stages	Setting Depth
10	1	15 FT.

PUMP TEST

Well yielded _____ GPM with

a drawdown of _____ ft.

after _____ hours of pumping

WELL DATA

Well Depth	Casing Diameter (In.)	Casing Length (Ft.)
390	2	380

Type of Casing	Hole Depth	Depth to Static Water Level
PVC	390	1

TYPE OF COMPLETION: (Circle One or More): Gravel Packed, Underreamed, Telescoped, (Natural Development) Open Hole, Other (Describe) _____

WELL GROUTED TO A DEPTH OF 10 FEET
Type Grout (circle one): Cement, Bentonite, or Mix

LOG DATA

TYPE OF LOG RUN (Circle One): No Log Run, Electric, Gamma Ray, Density, Sonic, Neutron, Other (Describe) _____

Name of Organization Running Log

GEOLOGIC DATA (Office Use Only)

Surface Elev.	Geologic Unit	Unit Thickness	Depth to Top
Subs. SWL	Date	Analysis	Aquifer Test

Driller's Remarks

SCREEN DATA

Diameter - Inches	Length - Feet	Slot Size - Inches
2	10	.012

Screen Type	Depth to Bottom - Feet
PVC	390

DESCRIPTION OF FORMATIONS ENCOUNTERED	FROM	TO
white clay	0	22
white sand	22	55
blue clay	55	315
blue sand	315	390

FORMATIONS (Continued)	FROM	TO

IF MORE SPACE IS NEEDED, USE BACK

RECEIVED
FEB 22 1994
Dept. of Environmental Quality
Office of Land & Water Resources

If well telescopes please sketch and show depths.

GROUND LEVEL

 

If more than one screen, show location of each on sketch.

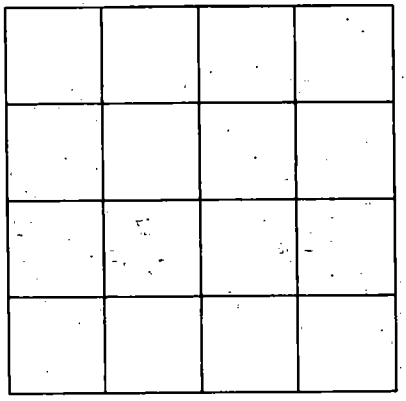

SECTION _____

Please indicate well location X.

ADDITIONAL INFORMATION