MISSISSIPPI DEPARTMENT OF ENVIRONMENTAL QUALITY
Office of Land and Water Resources

P. O. Box 10631
Jackson, MS 39289-0631
WATER WELL DRILLERS LOG

COUNTY WELL LOCATED: Hancock
WELL NUMBER: C 21/6 | CODED:
DATE WELL COMPLETED: 7/17/96
PERMIT NUMBER:
NAME OF DRILLING FIRM: Pouncey Water Well

NAME & MAILING ADDRESS OF LANDOWNER: Chris Cousins, Dummy Line Rd., Picayune MS.

WELL LOCATION: SEC 22 TOWNSHIP 6 (N/S) RANGE 15 (E/W)

DISTANCE: 6 1/2 Miles DIRECTION: N of NEAREST TOWN: Kiln

OTHER LANDMARK: across - Plantation

WELL PURPOSE (Home, Irrigation, Municipal, Industrial, Fish Pond, etc.): Home

PUMP DATA

PUMP TYPE (Circle One): Submersible, Turbine, Jet, Flowing Well, Other (Describe)

POWER TYPE (Circle One): Electric, Tractor, Diesel, Gasoline, Butane, Other (Describe) H/P 1

Pump Capacity (GPM)	No. of Stages	Setting Depth
10	5	60 FT.

PUMP TEST

Well yielded 16 GPM with a drawdown of — ft. after — hours of pumping

WELL DATA

Well Depth	Casing Diameter (in.)	Casing Length (Ft.)
350'	4	330

Type of Casing	Hole Depth	Depth to Static Water Level
PVC	350	39

TYPE OF COMPLETION: (Circle One or More): Gravel Packed, Underreamed, Telescoped, Natural Development, Open Hole, Other (Describe)

WELL GROUTED TO A DEPTH OF 10 FEET
Type Grout (circle one): Cement, Bentonite, or Mix

LOG DATA

TYPE OF LOG RUN (Circle One): No Log Run, Electric, Gamma Ray, Density, Sonic, Neutron, Other (Describe)

Name of Organization Running Log

GEOLOGIC DATA (Office Use Only)

Surface Elev.	Geologic Unit	Unit Thickness	Depth to Top
Subs. SWL	Date	Analysis	Aquifer Test

Driller's Remarks

Top of Lap Pipe or Reduction in Casing: 140 FEET

IF TELESCOPED OR MORE THAN ONE SCREEN OR GRAVEL SHEAR

SCREEN DATA

Diameter - Inches	Length - Feet	Slot Size - Inches
2	20	010

Screen Type	Depth to Bottom - Feet
PVC Wrap.	350

DESCRIPTION OF FORMATIONS ENCOUNTERED	FROM	TO
Clay	0	4
Sd. Crub Big		112
Clay Blue		294
Soft Sd.		350

FORMATIONS (Continued)	FROM	TO

IF MORE SPACE IS NEEDED, USE BACK

RECEIVED
AUG 19 1996
Dept. of Environmental Quality
Office of Land & Water Resources

If well telescopes please sketch and show depths.

GROUND LEVEL

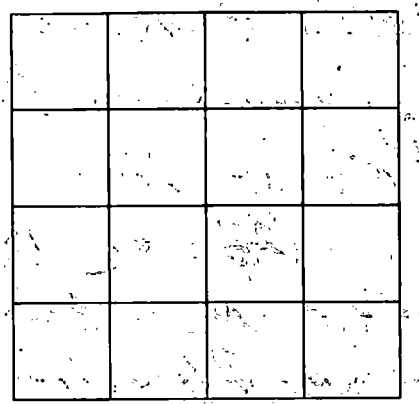

SECTION _____

Please indicate well location X.

ADDITIONAL INFORMATION

If more than one screen, show location of each on sketch.