# MISSISSIPPI DEPARTMENT OF NATURAL RESOURCES

Bureau of Land and Water Resources

P.O. Box 10631
Jackson, Mississippi 39209

## WATER WELL DRILLERS LOG

| | |
|---|---|
| COUNTY WELL LOCATED: Hancock | |
| WELL NUMBER: D 2063 | CODED: |
| DATE WELL COMPLETED: 3-17-90 | |
| PERMIT NUMBER: 0-493 | |
| NAME OF DRILLING FIRM: Bobby Beck's Well Works Inc. | |

NAME & MAILING ADDRESS OF LANDOWNER
Larry Leonard
2115 North Causeway
Metairie La 70001

| WELL LOCATION: SEC | TOWNSHIP | RANGE |
|---|---|---|
| 32 | 6 N/S | 14 E/W |

| DISTANCE | DIRECTION | NEAREST TOWN |
|---|---|---|
| Miles | of | |

OTHER LANDMARK

WELL PURPOSE: Home, Irrigation, Municipal, Industrial, Fish Pond, etc.

### PUMP DATA

PUMP TYPE (Circle One): Submersible, Turbine, Jet, Flowing Well, Other (Describe) 1 hp 2 Stage

POWER TYPE (Circle One): Electric, Tractor, Diesel, Gasoline, Butane, Other (Describe)

| Pump Capacity (GPM) | No. of Stages | Setting Depth |
|---|---|---|
| 10 | 2 | 59 FT. |

PUMP TEST

Well yielded _____ GPM with a drawdown of _____ ft. after _____ hours of pumping

### WELL DATA

| Well Depth | Casing Diameter (In.) | Casing Length (Ft.) |
|---|---|---|
| 487 | 2" | 20 ft. |
| **Type of Casing** | **Hole Depth** | **Depth to Static Water Level** |
| PVC. | 2" | 39 ft. |

TYPE OF COMPLETION: (Circle One or More): Gravel Packed, Underreamed, Telescoped, Natural Development, Open Hole, Other (Describe)

Top of Lap Pipe or Reduction in Casing FEET

IF TELESCOPED OR MORE THAN ONE SCREEN: USE BACK PAGE

### LOG DATA

TYPE OF LOG RUN (Circle One): No Log Run, Electric, Gamma Ray, Density, Sonic, Neutron, Other (Describe)

Name of Organization Running Log: Bobby Beck's Well Works

### GEOLOGIC DATA (Office Use Only)

| Surface Elev. | Geologic Unit | Unit Thickness | Depth to Top |
|---|---|---|---|
| Subs. SWL | Date | Analysis | Aquifer Test |

Driller's Remarks

### SCREEN DATA

| Diameter - Inches | Length - Feet | Slot Size - Inches |
|---|---|---|
| 2" | 20 ft. | #8 |
| **Screen Type** | | **Depth to Bottom - Feet** |
| Johnson Screen | | 487 |

| DESCRIPTION OF FORMATIONS ENCOUNTERED | FROM | TO | FORMATIONS (Continued) | FROM | TO |
|---|---|---|---|---|---|
| | | | | | |

IF MORE SPACE IS NEEDED, USE BACK

RECEIVED
JUN 05 1990
Department of Natural Resources
Bureau of Land & Water Resources

If well telescopes please
sketch and show depths.

GROUND LEVEL

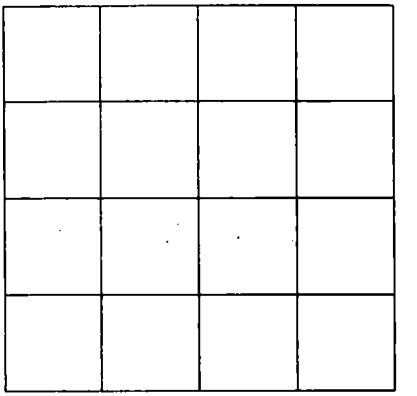

SECTION _____

Please indicate well location X.

ADDITIONAL INFORMATION

If more than one screen,
show location of each on sketch.