CODED

HANCOCK
F-19
5-1-71

MISSISSIPPI
BOARD OF WATER COMMISSIONERS
416 North State Street
Jackson, Mississippi 39201

CODED

WATER WELL DRILLERS LOG

5-1 1971 Earl Penton Water Well Serv. Hancock
date well completed — firm name — county well located

LANDOWNER: mr. Larry morse
Kiln Road Hwy 43
(mailing address)

WELL LOCATION:
sec. 11 T 7 N S R 15 E W
4 miles West of Kiln
(distance) (direction) (nearest town)

WELL PURPOSE: Home
(home, irrigation, municipal, industrial)

WELL COMPLETION DATA:

(1) diameter (inches) 4 5/8
(2) total depth (feet) 195
(3) static water level (feet) 46 below above top of ground.
(4) casing Galv. (material), 190 (depth),
2" (size) if telescope see back.
(5) screen 5 (length), 190-195 (depth to top)
2" (size), S.S. (material)
(6) pump 1 (HP) 5.50 H. (yield gpm)
Elect (type power)
(7) electric log NO (yes or no)
(organization running log)
(8) how well bottom plugged Shoe

DRILLERS REMARKS:

description of formations encountered	from	to
Red Clay	0	14
Co. Red & white Sd.	14	30
Red Clay	30	72
White Clay	72	92
Blue Clay	92	182
Med. Blue Sd.	182	195

CODED

AUG 24 1971
MISS. BD. OF WATER COMM.

If well telescopes please sketch and show depths.

GROUND LEVEL

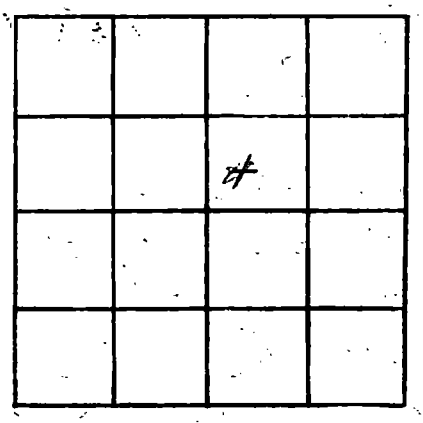

SECTION 11

Please indicate well location X.

ADDITIONAL INFORMATION

If more than one screen, show locations of each on sketch.