HANCOCK
F42
12-4-72

MISSISSIPPI
BOARD OF WATER COMMISSIONERS
416 North State Street
Jackson, Mississippi 39201

CODED

WATER WELL DRILLERS LOG

NEIL LUMPKIN WELL DRILLING SERVICE
P. O. BOX 117
GARDERE, MISS.

12-4 19 72
date well completed

Hancock
county well located

LANDOWNER: Frank Mack
Picayune, Ms.
Route 3
(mailing address)

WELL LOCATION:
sec. 19 T 7 N (S) R 15 E (W)
5 miles W of Kiln
(distance) (direction) (nearest town)

WELL PURPOSE: home
(home, irrigation, municipal, industrial)

WELL COMPLETION DATA:

(1) diameter (inches) 2"
(2) total depth (feet) 1176
(3) static water level (feet) 40 ~~below~~ above top of ground.
(4) casing 1132 blk. 42 galv. on top
(material) (depth)
2" (size) If telescope see back.
(5) screen 20' (length), (depth to top)
2" (size), Stainless Steel (material)
(6) pump (HP) (yield gpm)
(type power)
(7) electric log No. (yes or no)
(organization running log)
(8) how well bottom plugged

DRILLERS REMARKS: 40' above water level 20 lbs. pressure

description of formations encountered	from	to
Surface clay	0	10
" sand	10	80
Blue clay	80	320
Good sand	320	500
Blue clay	500	650
Sand	650	800
Clay	800	950
Sand	950	1000
Blue clay	1000	1100
Good sand (pea gravel)	1100	1176

CODED

If well telescopes please sketch and show depths.

GROUND LEVEL

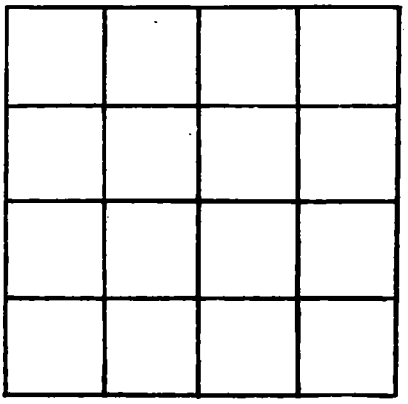

SECTION _____

Please indicate well location X.

ADDITIONAL INFORMATION

If more than one screen, show locations of each on sketch.