Hancock
F060
3-1-86

MISSISSIPPI DEPARTMENT OF NATURAL RESOURCES

Bureau of Land and Water Resources
Southport Mall
P.O. Box 10631
Jackson, Mississippi 39209

CODED

WATER WELL DRILLERS LOG

3-1-86 — date well completed
Penton Well Service — firm name
Hancock — county well located

LANDOWNER: A. J. Englande
Hwy 435
(mailing address)

WELL LOCATION:
sec. 10 T. 7 S R. 15 W
5 miles West of Kiln
(distance) (direction) (nearest town)

WELL PURPOSE: Home
(home, irrigation, municipal, industrial)

WELL COMPLETION DATA:

(1) diameter (inches) 2"
(2) total depth (feet) 470'
(3) static water level (feet) Flow below above top of ground.
(4) casing PVC (material), 460' (depth), 2" (size) If telescope see back.
(5) screen 10' (length), 460' (depth to top) 45P, 2" (size), PVC (material)
(6) pump 1/2 (HP) (yield gpm)
Elec (type power)
(7) electric log No (yes or no)
(organization running log)
(8) how well bottom plugged B.W.

DRILLERS REMARKS:

description of formations encountered	from	to
Clay	0	15
Red Sand	15	40
Clay	40	340
Sand	340	380
Clay & Sand	380	400
Sand	400	460

RECEIVED
APR - 1 1986
Department of Natural Resources
Bureau of Land & Water Resources

If well telescopes please sketch and show depths.

GROUND LEVEL

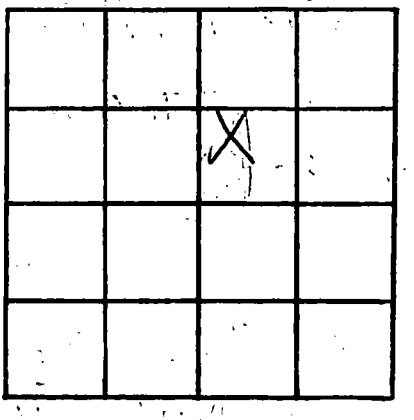

SECTION _____

Please indicate well location X.

ADDITIONAL INFORMATION

If more than one screen, show locations of each on sketch.