HANCOCK
G 81
8-4-71

MISSISSIPPI
BOARD OF WATER COMMISSIONERS
416 North State Street
Jackson, Mississippi 39201

CODED

WATER WELL DRILLERS LOG

Hancock Co.

8-4 1971 Earl Penton water well Serv.
date well completed — firm name — county well located

LANDOWNER: Mrs Mitise Guave
Kiln Miss.
(mailing address)

WELL LOCATION:
sec. 22 T 7 N R 14 E
3 miles East of Kiln
(distance) (direction) (nearest town)

WELL PURPOSE: Home
(home, irrigation, municipal, industrial)

WELL COMPLETION DATA:

(1) diameter (inches) 4 5/8
(2) total depth (feet) 347
(3) static water level (feet) 22 1/2 below above top of ground.
(4) casing Galv. (material), 337 (depth), 2" (size) If telescope see back.
(5) screen 10' (length), 337 (depth to top), 2" (size), S.S. (material)
(6) pump 1/2 (HP) 600 P. Hr. (yield gpm) Elect. (type power)
(7) electric log NO (yes or no)
(organization running log)
(8) how well bottom plugged Shoe

DRILLERS REMARKS:

description of formations encountered	from	to
Red Clay	0	3
White Corse Sd. & Gravel	3	20
White Clay	20	78
Blue clay	78	140
Fine Blue Sd.	140	145
Blue Clay	145	313
Fine Blue Sd.	313	330
Corse B[illegible]	330	347

CODED

NOV 29 1971

MISS. BD. OF WATER COMM.

If well telescopes please sketch and show depths.

GROUND LEVEL

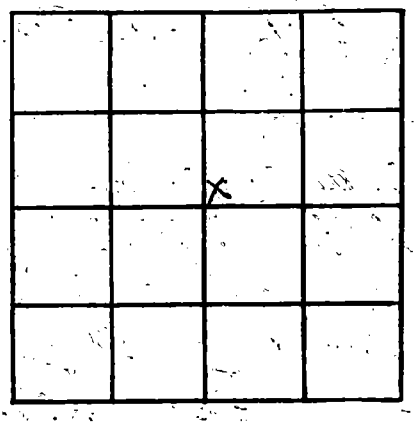

SECTION 22

Please indicate well location X.

ADDITIONAL INFORMATION

If more than one screen, show locations of each on sketch.