HANCOCK
G84
3-15-72

MISSISSIPPI
BOARD OF WATER COMMISSIONERS
416 North State Street
Jackson, Mississippi 39201

WATER WELL DRILLERS REPORT

CODED

3-15 1972 Panton Well Serv Hancock
date well completed — firm name — county well located

LANDOWNER: Armond Cuevas
Kiln
Miss.
(mailing address)

WELL LOCATION:
sec. 20 T. 7 N/S R. 14 E/W
1 (distance) miles North (direction) of Kiln (nearest town)

WELL PURPOSE: Home
(home, irrigation, municipal, industrial)

WELL COMPLETION DATA:

(1) diameter (inches) 2
(2) total depth (feet) 278
(3) static water level (feet) 26 below top of ground.
(4) casing Galv. (material), 273 (depth),
2 (size) if telescope see back.
(5) screen 5' (length), 273 (depth to top)
2 (size), S. Steel (material)
(6) pump 1/2 (HP) 10 (yield gpm)
Elec (type power)
(7) electric log NO (yes or no)
(organization running log)
(8) how well bottom plugged B.W. Value

DRILLERS REMARKS:

description of formations encountered	from	to
Surface Clay	0	18
Sand	18	55
White clay	55	65
Blue Clay	65	238
Sand	238	278

CODED

APR 11 1972
MISS. BD. OF
WATER COMM.

If well telescopes please sketch and show depths.

GROUND LEVEL

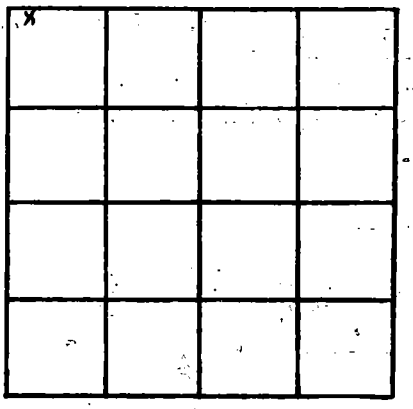

SECTION 20

Please indicate well location X.

ADDITIONAL INFORMATION

If more than one screen, show locations of each on sketch.