MISSISSIPPI DEPARTMENT OF NATURAL RESOURCES

Bureau of Land and Water Resources

P.O. Box 10631
Jackson, Mississippi 39209

WATER WELL DRILLERS LOG

COUNTY WELL LOCATED: Hancock	
WELL NUMBER: G 3010	CODED:
DATE WELL COMPLETED: Aug 23 1986	
PERMIT NUMBER:	
NAME OF DRILLING FIRM: McGill Pump & Well	

NAME & MAILING ADDRESS OF LANDOWNER

David Necaise
Rt. 1, Box 424
Pass Christian Ms.

WELL LOCATION: SEC 3 TOWNSHIP T7 (S) N RANGE R14 (W) E

DISTANCE 4 Miles **DIRECTION** WEST of **NEAREST TOWN** Dedeaux

OTHER LANDMARK home

WELL PURPOSE: Home, Irrigation, Municipal, Industrial, Fish Pond, etc.

PUMP DATA

PUMP TYPE (Circle One): Submersible, Turbine, (Jet) Flowing Well, Other (Describe) _____

POWER TYPE (Circle One): (Electric) Tractor, Diesel, Gasoline, Butane, Other (Describe) _____

Pump Capacity (GPM)	No. of Stages	Setting Depth
5	2	120' FT.

PUMP TEST

Well yielded 5 GPM with a drawdown of 2' ft. after 1 hours of pumping

WELL DATA

Well Depth	Casing Diameter (In.)	Casing Length (Ft.)
315'	2"	305'

Type of Casing	Hole Depth	Depth to Static Water Level
PVC	320'	103'

TYPE OF COMPLETION: (Circle One or More): Gravel Packed, Underreamed, Telescoped, (Natural Development) Open Hole, Other (Describe) _____

Top of Lap Pipe or Reduction in Casing FEET

IF TELESCOPED OR MORE THAN ONE SCREEN: USE BACK PAGE

LOG DATA

TYPE OF LOG RUN (Circle One): (No Log Run) Electric, Gamma Ray, Density, Sonic, Neutron, Other (Describe) _____

Name of Organization Running Log

GEOLOGIC DATA (Office Use Only)

Surface Elev.	Geologic Unit	Unit Thickness	Depth to Top
Subs. SWL	Date	Analysis	Aquifer Test

Driller's Remarks

SCREEN DATA

Diameter - Inches	Length - Feet	Slot Size - Inches
2"	10'	6 thousandth

Screen Type	Depth to Bottom - Feet
PVC	315'

DESCRIPTION OF FORMATIONS ENCOUNTERED	FROM	TO
Mud	0	110
Sand	110	130
Mud	130	270
Sand	270	320

FORMATIONS (Continued)	FROM	TO

IF MORE SPACE IS NEEDED, USE BACK

RECEIVED
NOV 3 1986
Department of Natural Resources
Bureau of Land & Water Resources

If well telescopes please sketch and show depths.

GROUND LEVEL

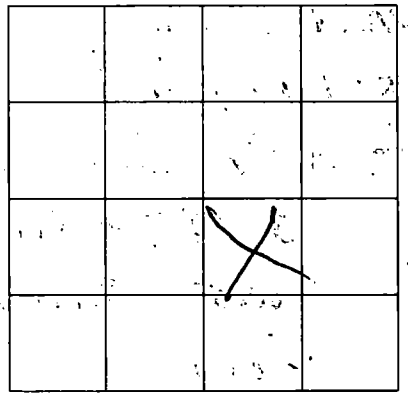

SECTION _____

Please indicate well location X.

ADDITIONAL INFORMATION

If more than one screen, show location of each on sketch.