MISSISSIPPI DEPARTMENT OF NATURAL RESOURCES

Bureau of Land and Water Resources

P.O. Box 10631
Jackson, Mississippi 39209

WATER WELL DRILLERS LOG

COUNTY WELL LOCATED: HANCOCK	
WELL NUMBER: G ~~3071~~ 2111	CODED:
DATE WELL COMPLETED: JAN. 8, 1987	
PERMIT NUMBER	
NAME OF DRILLING FIRM: WARD WELL DLG. RT. 2, BOX 350C, B.S.L.	

NAME & MAILING ADDRESS OF LANDOWNER
WALLY MONTEABACO
LADNER Rd.
PASS CHRISTIAN, MS.

WELL LOCATION: SEC 26 TOWNSHIP 7 N/S RANGE 14 E/W

DISTANCE 8 Miles DIRECTION S/E of NEAREST TOWN KILN

OTHER LANDMARK: JUST N OF DIAMOND HEAD

WELL PURPOSE: Home, Irrigation, Municipal, Industrial, Fish Pond, etc.
HOME

PUMP DATA

PUMP TYPE (Circle One): Submersible, Turbine, Jet, Flowing Well, Other (Describe) OWNERS

POWER TYPE (Circle One): Electric, Tractor, Diesel, Gasoline, Butane, Other (Describe)

Pump Capacity (GPM)	No. of Stages	Setting Depth
		FT.

PUMP TEST

Well yielded _____ GPM with a drawdown of _____ ft. after _____ hours of pumping

WELL DATA

Well Depth	Casing Diameter (In.)	Casing Length (Ft.)
240'	2"	230'

Type of Casing	Hole Depth	Depth to Static Water Level
SCH. 40 PVC	240'	-25'

TYPE OF COMPLETION: (Circle One or More): Gravel Packed, Underreamed, Telescoped, Natural Development, Open Hole, Other (Describe) HOLE BACKFILLED

Top of Lap Pipe or Reduction in Casing FEET

IF TELESCOPED OR MORE THAN ONE SCREEN: USE BACK PAGE

LOG DATA

TYPE OF LOG RUN (Circle One): No Log Run, Electric, Gamma Ray, Density, Sonic, Neutron, Other (Describe)

Name of Organization Running Log

GEOLOGIC DATA (Office Use Only)

Surface Elev.	Geologic Unit	Unit Thickness	Depth to Top
Subs. SWL	Date	Analysis	Aquifer Test

Driller's Remarks

RECEIVED
FEB 18 1987
Department of Natural Resources
Bureau of Land & Water Resources

SCREEN DATA

Diameter - Inches	Length - Feet	Slot Size - Inches
2"	10'	8 SLOT

Screen Type	Depth to Bottom - Feet
SCH. 80 PVC	

DESCRIPTION OF FORMATIONS ENCOUNTERED	FROM	TO
SANDY CLAY	0	10
SD	10	16
CLAY	16	110
FINE SD	110	126
CLAY - SILT	126	215
CORSE SD	215	240

FORMATIONS (Continued)	FROM	TO

IF MORE SPACE IS NEEDED, USE BACK

If well telescopes please
sketch and show depths.

GROUND LEVEL

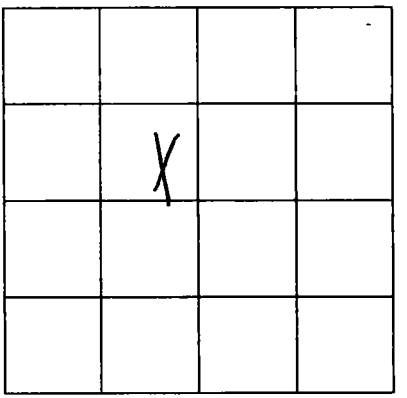

SECTION 26

Please indicate well location X.

ADDITIONAL INFORMATION

If more than one screen,
show location of each on sketch.