MISSISSIPPI DEPARTMENT OF NATURAL RESOURCES

Bureau of Land and Water Resources

P.O. Box 10631
Jackson, Mississippi 39209

WATER WELL DRILLERS LOG

COUNTY WELL LOCATED: HANCOCK	PERMIT NUMBER: 0-493
WELL NUMBER: G-2117	NAME OF DRILLING FIRM: Bobby Beach Well Work & Pump Repair
DATE WELL COMPLETED: 6-17-88	

NAME & MAILING ADDRESS OF LANDOWNER
Ronnie Lafontaine
Rt. 3 Box 484-B
Pass Christian MS. 39571

WELL LOCATION

SEC	TOWNSHIP		RANGE	
23	7	N / S	14	E / W

DISTANCE	DIRECTION	NEAREST TOWN
Miles	of	

OTHER LANDMARK:

WELL PURPOSE: (Home) Irrigation, Municipal, Industrial, Fish Pond, etc.

PUMP DATA

PUMP TYPE (Circle One): Submersible, Turbine, (Jet) Flowing Well, Other (Describe)

POWER TYPE (Circle One): (Electric) Tractor, Diesel, Gasoline, Butane, Other (Describe)

Pump Capacity (GPM)	No. of Stages	Setting Depth
13	2	40 FT.

PUMP TEST

Well yielded _____ GPM with a drawdown of _____ ft. after _____ hours of pumping

WELL DATA

Well Depth	Casing Diameter (In.)	Casing Length (Ft.)
366	2"	20

Type of Casing	Hole Depth	Depth to Static Water Level
PVC	366	26" inches

TYPE OF COMPLETION: (Circle One or More): Gravel Packed, Underreamed, Telescoped, (Natural Development), Open Hole, Other (Describe)

Top of Lap Pipe or Reduction in Casing: FEET

IF TELESCOPED OR MORE THAN ONE SCREEN: USE BACK PAGE

LOG DATA

TYPE OF LOG RUN (Circle One): Electric, Gamma Ray, (Density), Sonic, Neutron, Other (Describe) (No Log Run)

Name of Organization Running Log: Bobby Beach Well Works

SCREEN DATA

Diameter - Inches	Length - Feet	Slot Size - Inches
2"	20 ft.	#8

Screen Type	Depth to Bottom - Feet
Johnson Screen	366

GEOLOGIC DATA (Office Use Only)

Surface Elev.	Geologic Unit	Unit Thickness	Depth to Top
Subs. SWL	Date	Analysis	Aquifer Test

Driller's Remarks: Fine Well

DESCRIPTION OF FORMATIONS ENCOUNTERED	FROM	TO	FORMATIONS CONTINUED	FROM	TO

IF MORE SPACE IS NEEDED, USE BACK

RECEIVED
JUN 6 1989
Department of Natural Resources
Bureau of Land & Water Resources

If well telescopes please
sketch and show depths.

GROUND LEVEL

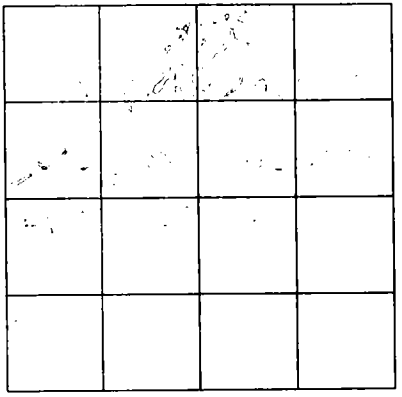

SECTION _____

Please indicate well location X.

ADDITIONAL INFORMATION

If more than one screen,
show location of each on sketch.