Hancock
K116
8-6-69

MISSISSIPPI
BOARD OF WATER COMMISSIONERS
416 North State Street
Jackson, Mississippi 39201

CODED

WATER WELL DRILLERS LOG

8-6 1969 Sutter Well Wks. Hancock
date well completed — firm name — county well located

LANDOWNER: D. A. FAUCHEUX
Box 15
HAHNVILLE, LA.
(mailing address)

WELL LOCATION:
sec. 37 T. 8 S R. 14 W
1 miles N of Bay St Louis
(distance) (direction) (nearest town)

WELL PURPOSE: home
(home, irrigation, municipal, industrial)

WELL COMPLETION DATA:

(1) diameter (inches) 2
(2) total depth (feet) 418'
(3) static water level (feet) 4' ~~below~~ above top of ground.
(4) casing galv, 408'
(material) (depth)
2" if telescope see back.
(size)
(5) screen 10', 408'
(length) (depth to top)
2", stainless steel
(size) (material)
(6) pump 1/3 10
(HP) (yield gpm)
elec
(type power)
(7) electric log no
(yes or no)
(organization running log)
(8) how well bottom plugged BPV slug

description of formations encountered	from	to
Clay	0	10
Sand	10	27
Clay	27	62
Sand	62	196
Clay	196	396
Sand	396	418

DRILLERS REMARKS:

JAN - 5 1969
MISS. BD. OF WATER COMM.

If well telescopes please sketch and show depths.

GROUND LEVEL

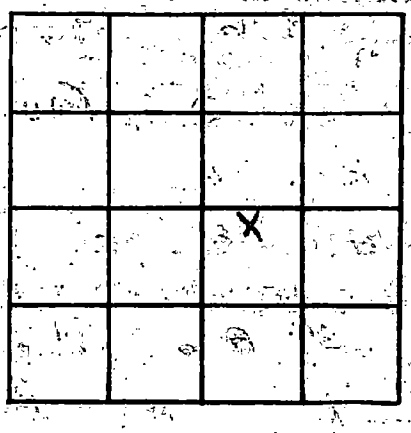

SECTION 37

Please indicate well location X.

ADDITIONAL INFORMATION

If more than one screen, show locations of each on sketch.