HANCOCK
K 160
12-18-69

MISSISSIPPI
BOARD OF WATER COMMISSIONERS
416 North State Street
Jackson, Mississippi 39201

CODED

WATER WELL DRILLERS LOG

Dec. 18 1969 — date well completed
McGill Well Wks — firm name
Hancock — county well located

LANDOWNER: Woodrow Farbe
Bay St. Louis
(mailing address)

WELL LOCATION:
sec. 4 T 9 N R 14 E (W)
1 miles E of Waveland
(distance) (direction) (nearest town)

WELL PURPOSE: Home
(home, irrigation, municipal, industrial)

WELL COMPLETION DATA:

(1) diameter (inches) 2"
(2) total depth (feet) 431'
(3) static water level (feet) 4' below above top of ground.
(4) casing ~~Wd Gal~~ (material), (depth),
No (size) if telescope see back.
(5) screen 10' - stainless steel (length) (~~depth to top~~)
2" (size), (material)
(6) pump ½ (HP) ~~Hole~~ 14 (yield gpm)
electric (type power)
(7) electric log No (yes or no)
No (organization running log)
(8) how well bottom plugged Sand - shark

DRILLERS REMARKS: NONE

description of formations encountered	from	to
top soil	0'	6'
Sand	6'	50'
Clay	50'	250'
Mud	250'	375'
Shells	375'	400'
Sand	400'	431'

CODED

DEC 22 1969
BD. OF
WR COMM.

If well telescopes please sketch and show depths.

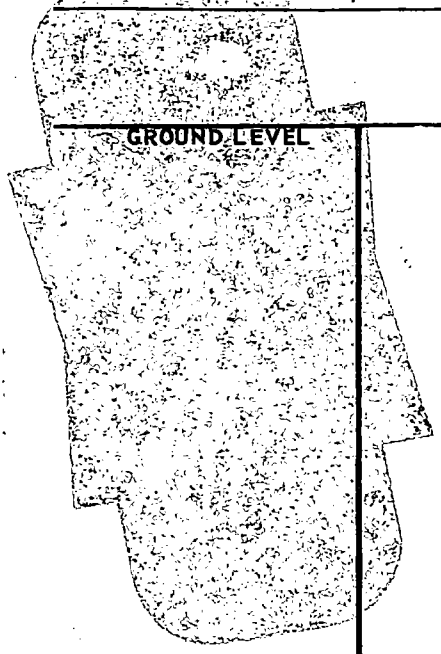

If more than one screen, show locations of each on sketch.

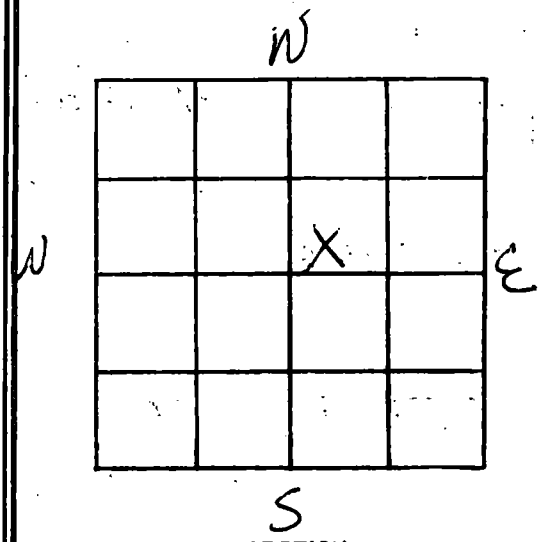

SECTION _____

Please indicate well location X.

ADDITIONAL INFORMATION