HANCOCK
K205
6-30-72

MISSISSIPPI
BOARD OF WATER COMMISSIONERS
416 North State Street
Jackson, Mississippi 39201

CODED

WATER WELL DRILLERS LOG

June 30 1972 — date well completed
Sutter Well Works — firm name
Hancock — county well located

LANDOWNER: John McDonald
Bay St. Louis, Miss.
(mailing address)

WELL LOCATION:
sec. 23 T 9 S R 14 W
4 (distance) miles NW (direction) of Bay St. Louis (nearest town)

WELL PURPOSE: home
(home, irrigation, municipal, industrial)

WELL COMPLETION DATA:

(1) diameter (inches) 2"
(2) total depth (feet) 423'
(3) static water level (feet) 2' ~~below~~ above top of ground.
(4) casing galv. (material), 413' (depth), 2" (size) if telescope see back.
(5) screen 10' (length), 413' (depth to top), 2" (size), stainless steel (material)
(6) pump owner's (HP) (yield gpm)
(type power)
(7) electric log no (yes or no)
(organization running log)
(8) how well bottom plugged B.P. Valve

DRILLERS REMARKS:

description of formations encountered	from	to
Sand	0	20
Clay	20	259
Sand - fine	259	286
Clay	286	390
Sand	390	423

CODED

JUL 24 1972
MISS. BD. OF WATER COMM.

If well telescopes please sketch and show depths.

GROUND LEVEL

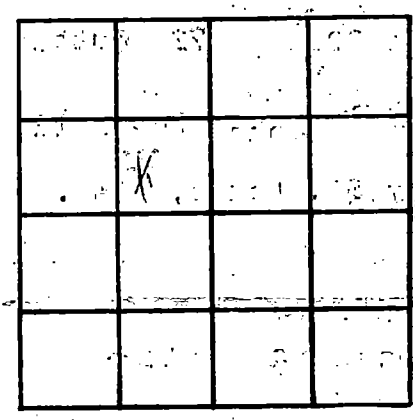

SECTION 23

Please indicate well location X.

ADDITIONAL INFORMATION

*If more than one screen, show locations of each on sketch.