HANCOCK
K 216
6-3-72

MISSISSIPPI
BOARD OF WATER COMMISSIONERS
416 North State Street
Jackson, Mississippi 39201

WATER WELL DRILLERS LOG

CODED

June 3 19 72 — date well completed
Sutter Well Works — firm name
Hancock — county well located

LANDOWNER: T.L.James & Co.
Ruston, Louisiana
(mailing address)

WELL LOCATION:
sec. 13 T. 8 ~~N~~ S R. 14 ~~E~~ W
3 (distance) miles S (direction) of Fenton (nearest town)

WELL PURPOSE: industrial
(home, irrigation, municipal, industrial)

WELL COMPLETION DATA:

(1) diameter (inches) 4" x 6"
(2) total depth (feet) 707'
(3) static water level (feet) 25' below ~~above~~ top of ground.
(4) casing blk.steel (material), 677' (depth), 4" x 6" (size) if telescope see back.
(5) screen 30' (length), 677' (depth to top), 4" (size), stgalvanized (material)
(6) pump 5 (HP) 150 (yield gpm)
elec. (type power)
(7) electric log no (yes or no)
(organization running log)
(8) how well bottom plugged B.P.Valve

DRILLERS REMARKS:

description of formations encountered	from	to
Clay	0	8
Sand & gravel	8	79
Clay	79	180
Sand	180	202
Clay	202	445
Sand	445	480
(Rock	484	486)
Clay	480	643
Sand	643	707

CODED

If well telescopes please sketch and show depths.

GROUND LEVEL

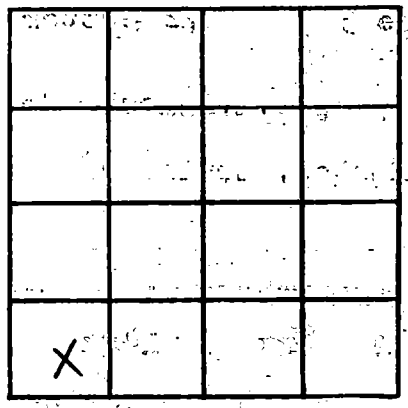

SECTION 13

Please indicate well location X.

ADDITIONAL INFORMATION

If more than one screen, show locations of each on sketch.