Hancock
K 456

MISSISSIPPI DEPARTMENT OF NATURAL RESOURCES

Bureau of Land and Water Resources
Southport Mall
P.O. Box 10631
Jackson, Mississippi 39209

WATER WELL DRILLERS LOG

07/03 1987 — date well completed
Layne Central Co. — firm name
Hancock — county well located

LANDOWNER: City of Bay St. Louis, MS.
Bay St. Louis, Miss. (mailing address)

WELL LOCATION: Ioor St. Well
sec. 35 T 8 N (S) R 14 E (W)
miles (distance) (direction) of (nearest town)

WELL PURPOSE: Municipal (home, irrigation, municipal, industrial)

WELL COMPLETION DATA:

(1) diameter (inches) 16"
(2) total depth (feet) 1125'
(3) static water level (feet) Flow below above top of ground.
(4) casing Steel (material), 1045' (depth),
16" (size) If telescope see back. 83'6" of 10"
(5) screen 70'10" (length), 1045' (depth to top)
10" (size), Stainless Steel (material)
(6) pump 60 (HP) 1000 (yield gpm)
Electrical (type power)
(7) electric log YES (yes or no)
Layne-Central Co (organization running log)
(8) how well bottom plugged BPV

DRILLERS REMARKS:
Permit No: GW 7347

description of formations encountered	from	to
Sand	0	3
Clay	3	9
Sand	9	30
Clay Sandy	30	58
Clay	58	70
Sand	70	144
Clay	144	210
Sand & Clay	210	266
Sand Clay	266	418
Sand clay	418	479
Clay	479	562
Sand Shale	562	660
Clay Sandy	660	723
Clay Hard	723	884
Sand	884	898
Clay	898	940
Sandy Clay	940	1011
Sandy Clay	1011	1048
Sand	1048	1117
Clay	1117	1124

If well telescopes please sketch and show depths.

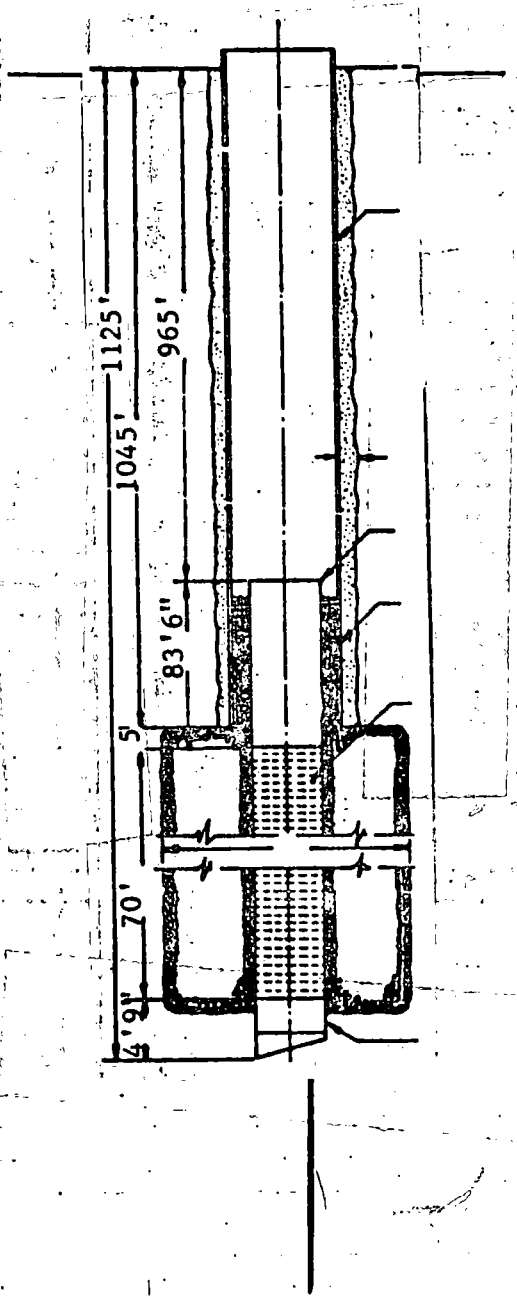

If more than one screen, show locations of each on sketch.

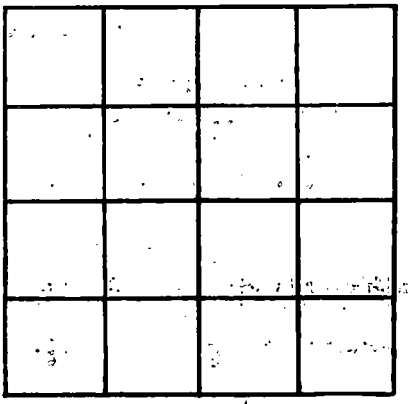

SECTION _____

Please indicate well location X.

ADDITIONAL INFORMATION