

Part 2 never received 3/13

# State Well Report

## Part 1

Mississippi Department of Environmental Quality  
Office of Land and Water Resources  
P.O. Box 10631  
Jackson, MS 39289-0631  
(601) 961-5210  
(601) 354-6938 (fax)

### For Office Use Only:

Aquifer: \_\_\_\_\_  
Well #: K-880  
L. S. Elevation: \_\_\_\_\_  
E-log #: \_\_\_\_\_

County: Hancock  
Permit #: \_\_\_\_\_  
Driller: Coast Water wells serv.  
Date drilling completed: 1-6-09

State Law requires that this report be prepared by the driller in detail and filed with the Department within 30 days of completion of drilling of the well.

Well Owner Information	Well Location
Owner Name: <u>Oil Equipment Co.</u>	Latitude: <u>30° 21' 30.9"</u> Longitude: <u>089° 25' 38.8"</u>
Mailing Address: <u>Hwy 603</u>	Method of Lat/Long (circle one): Conventional Survey, <u>19</u>
<u>Bay St. Louis, Ms 39576</u>	USGS quad, <u>(Hand-held GPS)</u> Survey-grade GPS
City State Zip Code	<u>1R 1/4 NW 1/4 Sec 17</u> Twn <u>8S</u> Rng <u>14W</u>
Telephone No. <u>205 288-5783</u>	Distance Direction Nearest Town
	Miles <u>NORTH</u> of <u>Bay St. Louis</u>

DO NOT  
HAVE  
HANCOCK  
COUNTY  
MAP

**Well Data**

Purpose of Well (circle one) Home Industrial Public Supply Irrigation Fish Culture Other: Service station

Date well drilling started: 1-2-09 Date well drilling completed: 1-6-09

If flowing, method of flow regulation: Valve Other (describe) Flanges w/ sub pump <sup>N.G.</sup> overhead

Static Water Level: Flow 106 gm feet above or below (circle one) land surface Date measured: 1-6-09

Method of Measurement (circle one) steel tape electric tape air line other: \_\_\_\_\_

Hole depth: 630 FT Well depth: 630 FT Well grouted to a depth of 10 feet

Type of grout (circle one): Cement Bentonite Mix

Casing length: 410' x 2" feet Casing diameter: 4" x 2" inches Type of casing: PVC

Screen length: 20 feet Screen diameter: 2 inches Type of screen: PVC

Screen slot size: .006 inches Setting depth: From 610 feet to 630 feet

Type of completion (circle all applicable): Gravel packed Underreamed Telescoped Open hole Natural Development

Other (describe): \_\_\_\_\_

Top of lap pipe or reduction in casing: N/A feet. If telescoped or more than one screen, describe on back of page

Logs run (circle all applicable) No log run Electric Gamma Ray Density Sonic Neutron Other: \_\_\_\_\_

Name of organization running log(s): N/A

I certify that the well was drilled, constructed, and completed in accordance with all applicable requirements of the Mississippi Department of Environmental Quality and/or the Mississippi Department of Health regulations and state laws.

Jack Ridgell 0-4-12  
Print Name of Water Well Contractor and License No.


Jack Ridgell  
Signature of Water Well Contractor

RECEIVED  
JAN 21 2009  
BY: OLWR

K-880

If well telescopes please sketch below and show depths.

Ground Level

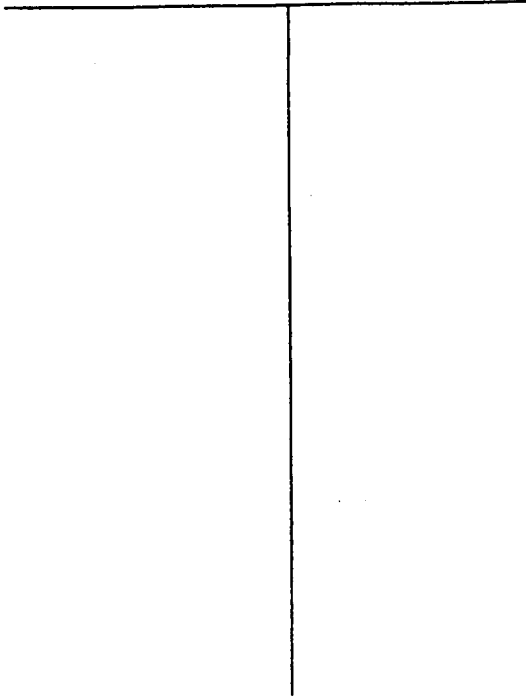


Description of Formations Encountered	From	To
Orange sandy clay	0	2
Orange + white clay	2	17
white coarse sand w/pea gravel	17	45
Blue clay	45	94
Orange coarse sand w/pea gravel	94	129
Blue clay w/streaks of sand	129	390
Gray medium sand	390	402
Blue clay w/streaks of sand	402	600
Gray medium to coarse sand	600	630

If more than one screen, show location of each on sketch

Sketch the property layout and include the following: 1) the well location; 2) any permanent structures on the property that may aid in locating the well; 3) any roads, power lines, or other items that may aid in locating the property and the well; 4) indicate direction.

DID NOT HAVE A HANCOCK COUNTY MAP - COULD NOT GET SECTION OR 1/4 SECTION

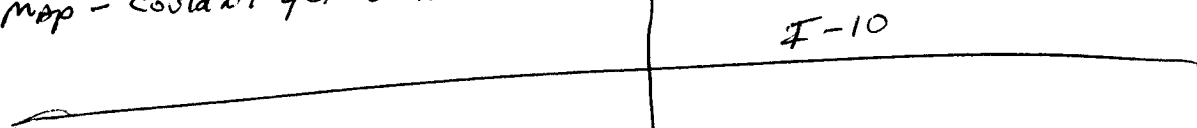

NOTE: 2<sup>ND</sup> - PROPERTY ON WEST SIDE OF HWY 603 SOUTH OF INTERSTATE 10



Landowner Name: Oil Equipment Co.

*John Reddick*  
Signature of Water Well Contractor

RECEIVED  
JAN 21 2009  
BY: OLWR