

K 2014

7-12-62

WATER WELL DRILLERS LOG

K

Date: 7-12, 1962, Driller: Lutter Well Works County Hancock  
 (Name)

(1) Owner of Land: Lewis Bernard  
 (Name)  
New Orleans La.  
 (Address)

(2) Location: NE 1/4, NE 1/4, Sec. 46 T85R14  
3 miles NE of Bay St Louis  
 (distance) (direction) (Nearest Town)

(3) Topography: flat  
 (Hilly) (Plain) (Level)

(4) Purpose of Well: Domestic Home  
 (Domestic Irrigation  
 Municipal, Industrial, Other)

Description & Color of Materials Sand, Clay, Red Clay, Shell, etc.	Thick- ness Feet	Depth Feet
Clay	10	10
sand	22	32
Clay	39	71
sand	30	101
Clay	31	132
sand	20	152

Information upon completion of well:

(1) Diameter 2 inches.

(2) Total Depth 152 feet.

(3) Water Level 3 feet below top of ground.

(4) Cased to 147, Size 2"


(5) Screen: Size 2", Length 5'

(6) Were any formations sealed against pollution?  
 \_\_\_\_\_ yes,  no.

If YES depth of formation \_\_\_\_\_

Why \_\_\_\_\_

Drillers Remarks: \_\_\_\_\_

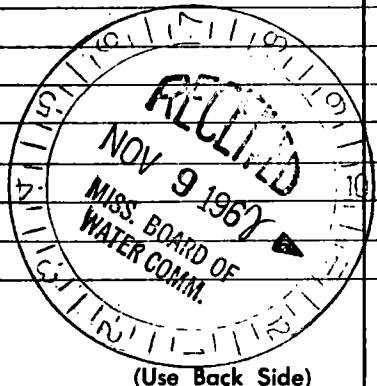

Well No.










