Hancock
K2168
8-67

MISSISSIPPI
BOARD OF WATER COMMISSIONERS
416 North State Street
Jackson, Mississippi 39201

WATER WELL DRILLERS LOG

8-11 1967 Sutter Well Works Hancock
date well completed — firm name — county well located

LANDOWNER: Chas. Breath
Bay St. Louis
Miss.
(mailing address)

WELL LOCATION:
sec. 37 T. 8S R. 14W
_____ miles IN Bay St Louis
(distance) (direction) (nearest town)

WELL PURPOSE: Commercial
(home, irrigation, municipal, industrial)

WELL COMPLETION DATA:

(1) diameter (inches) 2
(2) total depth (feet) 598
(3) static water level (feet) 4 ~~below~~ ABOVE top of ground.
(4) casing Galv. (material), 588' (depth),
2" (size) if telescope see back.
(5) screen 10' (length), 588' (depth to top)
2" (size), Stainless steel (material)
(6) pump unknown (HP) (yield gpm)
_____ (type power)
(7) electric log no (yes or no)
_____ (organization running log)
(8) how well bottom plugged BP Valve

DRILLERS REMARKS:

description of formations encountered	from	to
Clay	0	10
Sand	10	38
Clay	38	56
Sand	56	178
Clay	178	206
Sand	206	216
Clay	216	420
Sand - fine	420	447
Clay	447	568
Sand	568	598

RECEIVED OCT 5 1967 MISS. BOARD OF WATER COMM.

If well telescopes please sketch and show depths.

GROUND LEVEL

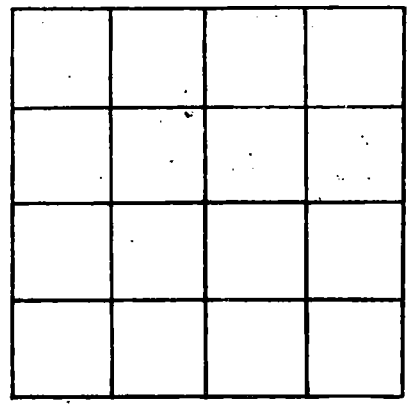

SECTION _____

Please indicate well location X.

ADDITIONAL INFORMATION

If more than one screen, show locations of each on sketch.