HANCOCK
K 2186
4-68

MISSISSIPPI
BOARD OF WATER COMMISSIONERS
416 North State Street
Jackson, Mississippi 39201

WATER WELL DRILLERS LOG

4-10 1968 Sutter Well Works Hancock
date well completed — firm name — county well located

LANDOWNER: Eliz. Cuevas
Rt. 1
Bay St Louis Miss
(mailing address)

WELL LOCATION:
sec. 29 T. 8 S R. 14 W
4 miles W of Bay St Louis
(distance) (direction) (nearest town)

WELL PURPOSE: home
(home, irrigation, municipal, industrial)

WELL COMPLETION DATA:

(1) diameter (inches) 2
(2) total depth (feet) 173
(3) static water level (feet) 1/2 below ~~above~~ top of ground.
(4) casing galv. (material), 168' (depth), 2" (size) if telescope see back.
(5) screen 5' (length), 168' (depth to top), 2" (size), stainless steel (material)
(6) pump unknown (HP) (yield gpm)
(type power)
(7) electric log no (yes or no)
(organization running log)
(8) how well bottom plugged BP Value

DRILLERS REMARKS:

description of formations encountered	from	to
Clay	0	12
Sand	12	36
Clay	36	78
Sand	78	115
Clay	115	153
Sand	153	173

MAY 29 1968
MISS. BD. OF WATER COMM.

If well telescopes please sketch and show depths.

GROUND LEVEL

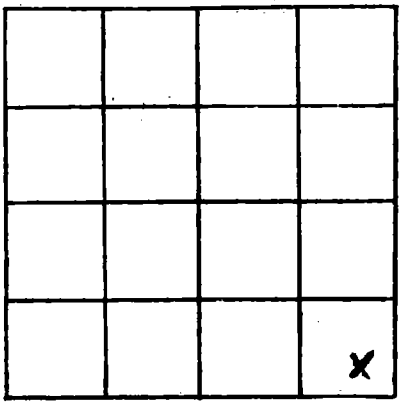

SECTION 29

Please indicate well location X.

ADDITIONAL INFORMATION

If more than one screen, show locations of each on sketch.