Hancock
K 2189
5-68

MISSISSIPPI
BOARD OF WATER COMMISSIONERS
416 North State Street
Jackson, Mississippi 39201

WATER WELL DRILLERS LOG

5-1 1968 — date well completed
Sutter Well Works — firm name
Hancock — county well located

LANDOWNER: E. C. Wiemann
435 S. Scott St
New Orleans, La.
(mailing address)

WELL LOCATION:
sec. 17 T 8 S R 14 W
5 miles NW of Bay St Louis
(distance) (direction) (nearest town)

WELL PURPOSE: home
(home, irrigation, municipal, industrial)

WELL COMPLETION DATA:

(1) diameter (inches) 2
(2) total depth (feet) 121
(3) static water level (feet) 1 ~~below~~ above top of ground.
(4) casing Galv. (material), 116' (depth), 2" (size) if telescope see back.
(5) screen 5' (length), 116' (depth to top), 2" (size), Stainless Steel (material)
(6) pump 1/2 (HP) 10 (yield gpm) elec. (type power)
(7) electric log no (yes or no)
(organization running log)
(8) how well bottom plugged BP Value

DRILLERS REMARKS:

description of formations encountered	from	to
Clay	0	18
sand	18	28
Clay	28	65
sand	65	77
Clay	77	106
sand	106	121

MAY 20 1968
MISS. BD. OF WATER COMM.

If well telescopes please sketch and show depths.

GROUND LEVEL

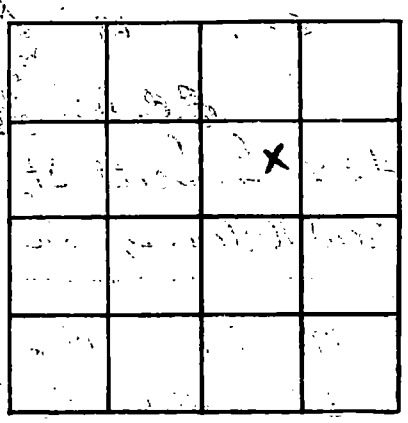

SECTION 17

Please indicate well location X.

ADDITIONAL INFORMATION

If more than one screen, show locations of each on sketch.