HANCOCK
K 2234
11-22-76

138

MISSISSIPPI
BOARD OF WATER COMMISSIONERS
416 North State Street
Jackson, Mississippi 39201

WATER WELL DRILLERS LOG

11-22 1976 Ward Well Drilling Hancock
date well completed — firm name — county well located

LANDOWNER: Albert Strong
Rt. 2, Box 382
Bay St. Louis, Miss.
(mailing address)

WELL LOCATION:
sec. 18 T. 9 N (S) R. 14 E (W)
10 (distance) miles S/W (direction) of B.S.L. (nearest town)

WELL PURPOSE: Home
(home, irrigation, municipal, industrial)

WELL COMPLETION DATA:
(1) diameter (inches) 2"
(2) total depth (feet) 301
(3) static water level (feet) 6 below (above) top of ground.
(4) casing PVC (material), 191 (depth), 2" (size) If telescope see back.
(5) screen 10 (length), — (depth to top), 2" (size), PVC (material)
(6) pump 1/2 (HP) 10 (yield gpm) Elec. (type power)
(7) electric log NO (yes or no) N/A (organization running log)
(8) how well bottom plugged BWV

DRILLERS REMARKS: N/A

description of formations encountered	from	to
Top Soil-Clay	0	19
Sd	19	45
Clay-Shell	45	96
Sd-Fine Gravel	96	118
Clay-Silt	118	246
Coarse Sd	246	301

RECEIVED
DEC 28 1976
MISS. BD. OF WATER COMM

If well telescopes please sketch and show depths.

GROUND LEVEL

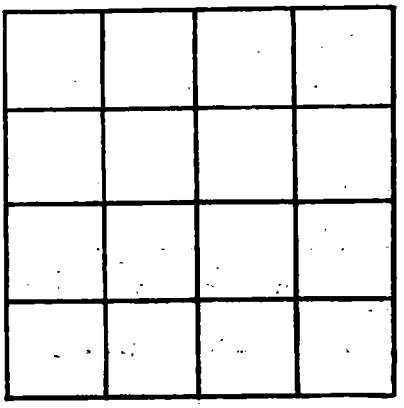

SECTION 18

Please indicate well location X.

ADDITIONAL INFORMATION

If more than one screen, show locations of each on sketch.