Hancock
K 23/3
4-16-80

MISSISSIPPI
BOARD OF WATER COMMISSIONERS
416 North State Street
Jackson, Mississippi 39201

WATER WELL DRILLERS LOG

4-16 1980 Wood Well Dlg. Hancock
date well completed — firm name — county well located

LANDOWNER Steve Daigrepont
River Side Dr.
Bay St. Louis Miss
(mailing address)

WELL LOCATION:
sec. 29 T 8 N (S) R 14 E (W)
11 miles NW of BSL
(distance) (direction) (nearest town)

WELL PURPOSE: Home
(home, irrigation, municipal, industrial)

WELL COMPLETION DATA:
(1) diameter (inches) 2"
(2) total depth (feet) 160'
(3) static water level (feet) 3 below above top of ground.
(4) casing PVC (material), 150 (depth),
— (size) If telescope see back.
(5) screen 10' (length), — (depth to top)
2" (size), PVC (material)
(6) pump Owner (HP) — (yield gpm)
— (type power)
(7) electric log no (yes or no)
N/A (organization running log)
(8) how well bottom plugged BW

DRILLERS REMARKS: Located in Shoreline Park.

description of formations encountered	from	to
Fill - clay	0	18
Sd	18	36
Clay - Silt	36	140
Med Sd.	140	160

DEPT. OF NATURAL RESOURCES
BUREAU OF LAND & WATER RESOURCES
MAY 20 1980
RECEIVED

If well telescopes please sketch and show depths.

GROUND LEVEL

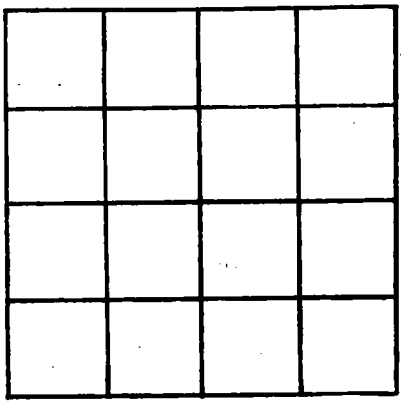

SECTION 11

Please indicate well location X.

ADDITIONAL INFORMATION

If more than one screen, show locations of each on sketch.