HANCOCK
K 2380
9-3-81

MISSISSIPPI
BOARD OF WATER COMMISSIONERS
416 North State Street
Jackson, Mississippi 39201

WATER WELL DRILLERS LOG

9-3- 1981 — date well completed
Ward Well Drilling — firm name
Hancock — county well located

LANDOWNER: Ben Moran
Rt. 3, Box 80
Bay St. Louis, Ms.
(mailing address)

WELL LOCATION:
sec. 22 T 8 (N) (S) R 13 (E) (W)
8 (distance) miles N/W (direction) of B.S.L. (nearest town)

WELL PURPOSE: Home
(home, irrigation, municipal, industrial)

WELL COMPLETION DATA:

(1) diameter (inches) 2"
(2) total depth (feet) 180
(3) static water level (feet) 5 below (above) top of ground.
(4) casing PVC (material), 120 (depth), — (size) if telescope see back.
(5) screen 10' (length), — (depth to top)
2" (size), PVC (material)
(6) pump owner (HP) (yield gpm)
— (type power)
(7) electric log NO (yes or no)
N/A (organization running log)
(8) how well bottom plugged BWV

DRILLERS REMARKS: N/A

description of formations encountered	from	to
Fill-Clay	0	18
Sd	18	44
Clay	44	80
Fine Sd	80	95
Clay-Silt	95	165
Sd	165	180

DEPT. OF NATURAL RESOURCES
BUREAU OF LAND & WATER RESOURCES
OCT -5 1981
RECEIVED

If well telescopes please sketch and show depths.

GROUND LEVEL

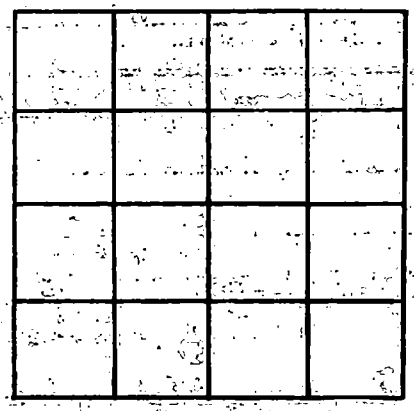

SECTION 22

Please indicate well location X.

ADDITIONAL INFORMATION

If more than one screen, show locations of each on sketch.