Hancock
K 2487
5/5

135

MISSISSIPPI
BOARD OF WATER COMMISSIONERS
416 North State Street
Jackson, Mississippi 39201

WATER WELL DRILLERS LOG

May 5 — date well completed
19 77 — Lane Well Works — firm name
Hancock — county well located

LANDOWNER: M. L. Glas
RT 2. Bay St. Louis
Miss.
(mailing address)

WELL LOCATION:
sec. 29 T 8 N (S) R 14 E (W) 13
? 6 miles (distance) E (direction) of B.S.L. (nearest town)

WELL PURPOSE:
(home, irrigation, municipal, industrial)

WELL COMPLETION DATA:

(1) diameter (inches) 2
(2) total depth (feet) 170
(3) static water level (feet) 1 (below / above) top of ground.
(4) casing Plastic (material), 170 (depth),
(size) if telescope see back.
(5) screen 10 (length), 170 (depth to top)
2 (size), Plastic (material)
(6) pump 1/3, 33 (HP) 5 (yield gpm)
Electric (type power)
(7) electric log (yes or no)
(organization running log)
(8) how well bottom plugged B.W.V.

DRILLERS REMARKS:

description of formations encountered	from	to
Red Clay	0	10
Red Clay	10	20
Sand White	20	30
Sand -"	30	40
Clay Blue	40	50
Clay Blue	50	60
Sand	60	80
Sand	90	90
Clay Blue	90	100
Clay Blue	100	110
Clay Sand	110	120
Clay Sand	120	130
Clay Blue	130	140
Clay Blue	140	150
Sand Blue	150	160
Sand & Gravel	160	170

RECEIVED
MAR 16 1977
MISS. BD. OF WATER COMM

If well telescopes please sketch and show depths.

GROUND LEVEL

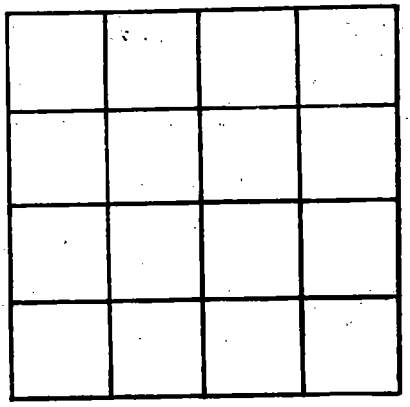

SECTION _____

Please indicate well location X.

ADDITIONAL INFORMATION

If more than one screen, show locations of each on sketch.