MISSISSIPPI DEPARTMENT OF NATURAL RESOURCES

Bureau of Land and Water Resources

P.O. Box 10631
Jackson, Mississippi 39209

WATER WELL DRILLERS LOG

COUNTY WELL LOCATED	HANCOCK
WELL NUMBER	K 2705
CODED	
DATE WELL COMPLETED	5-7-87
PERMIT NUMBER	
NAME OF DRILLING FIRM	Braden Pump & Well Service, Inc. 17170 Country Cove Saucier, MS 39574
	M&B Drilling Co

NAME & MAILING ADDRESS OF LANDOWNER

TONY VAZ
233 AKOKO
DIAMONDHEAD
PASS CHRISTIAN MS 39571

WELL LOCATION: SEC 10 TOWNSHIP 8 S RANGE 14 W

DISTANCE 5 Miles DIRECTION E/O of Diamondhead

OTHER LANDMARK

WELL PURPOSE: Home, Irrigation, Municipal, Industrial, Fish Pond, etc.
Home

PUMP DATA

PUMP TYPE (Circle One): Submersible, Turbine, Jet Flowing Well, Other (Describe)

POWER TYPE (Circle One): Electric, Tractor, Diesel, Gasoline, Butane, Other (Describe)

Pump Capacity (GPM)	No. of Stages	Setting Depth
25		80 FT.

PUMP TEST

Well yielded 25 GPM with a drawdown of _____ ft. after _____ hours of pumping

WELL DATA

Well Depth	Casing Diameter (In.)	Casing Length (Ft.)
240'	200' - 4" 40 - 2"	230
Type of Casing	**Hole Depth**	**Depth to Static Water Level**
PVC	240	2'

TYPE OF COMPLETION: (Circle One or More): Gravel Packed, Underreamed, Telescoped, Natural Development, Open Hole, Other (Describe)

Top of Lap Pipe or Reduction in Casing FEET

IF TELESCOPED OR MORE THAN ONE SCREEN: USE BACK PAGE

LOG DATA

TYPE OF LOG RUN (Circle One): No Log Run, Electric, Gamma Ray, Density, Sonic, Neutron, Other (Describe)

Name of Organization Running Log

GEOLOGIC DATA (Office Use Only)

Surface Elev.	Geologic Unit	Unit Thickness	Depth to Top
Subs. SWL	Date	Analysis	Aquifer Test

Driller's Remarks

SCREEN DATA

Diameter - Inches	Length - Feet	Slot Size - Inches
2"	10	.008
Screen Type	**Depth to Bottom - Feet**	
PVC-WOP	240	

RECEIVED
AUG 18 1987
Department of Natural Resources
Bureau of Land & Water Resources

DESCRIPTION OF FORMATIONS ENCOUNTERED	FROM	TO
Surface	0	6
Sand & Wood	6	85
Blue Clay	85	153
Fine Sand	153	164
Blue Clay	164	210
Grey Sand	210	240
Blue Clay	240	—

FORMATIONS (Continued)	FROM	TO

IF MORE SPACE IS NEEDED, USE BACK

If well telescopes please
sketch and show depths.

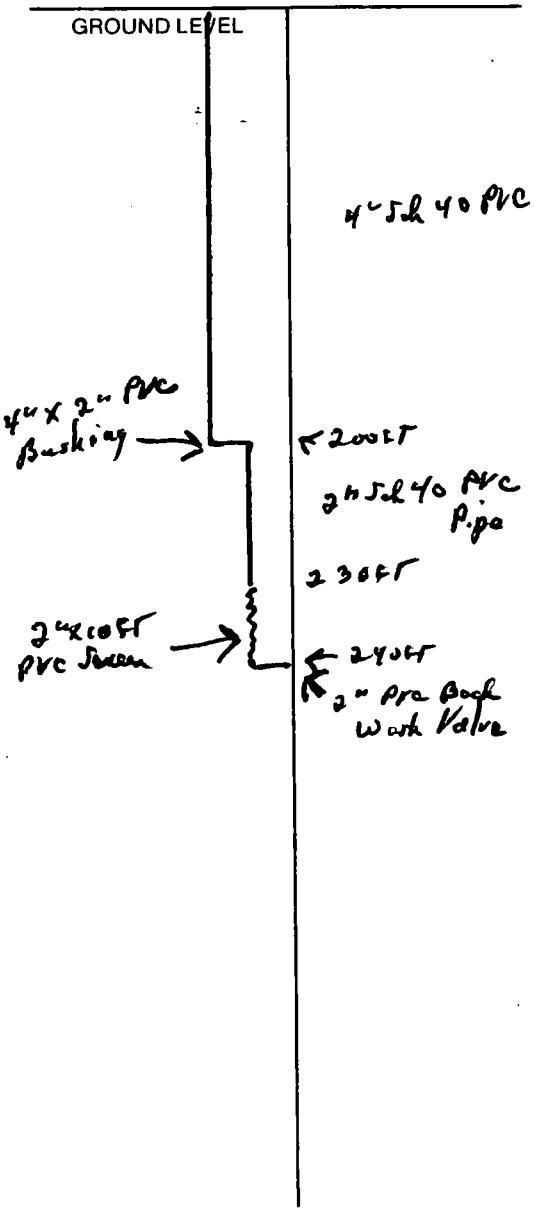

If more than one screen,
show location of each on sketch.

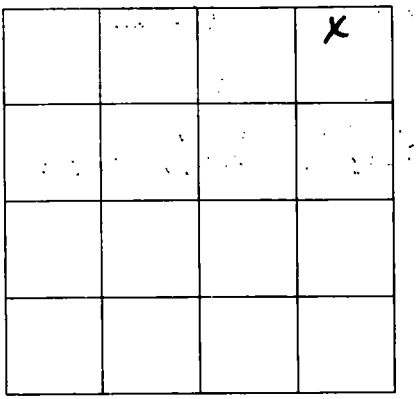

SECTION 10

Please indicate well location X.

ADDITIONAL INFORMATION