MISSISSIPPI DEPARTMENT OF NATURAL RESOURCES

Bureau of Land and Water Resources

P.O. Box 10631
Jackson, Mississippi 39209

WATER WELL DRILLERS LOG


WELL NUMBER: K2711 CODED

DATE WELL COMPLETED: June 3 1987

PERMIT NUMBER:

NAME OF DRILLING FIRM: Wardwell Dly.

NAME & MAILING ADDRESS OF LANDOWNER: Jessie W. Blount, Lakeshore Rd., Boy St. Louis Ms.

WELL LOCATION: SEC 5 18 S24 S?01 TOWNSHIP 9 N (S) RANGE 14 E (W)

DISTANCE: 1 1/2 Miles DIRECTION: S/E NEAREST TOWN: of Lakeshore

OTHER LANDMARK: Lakeshore Rd.

WELL PURPOSE: Home, Irrigation, Municipal, Industrial, Fish Pond, etc.: Home

PUMP DATA

PUMP TYPE (Circle One): Submersible, Turbine, Jet, Flowing Well, Other (Describe) Screw

POWER TYPE (Circle One): Electric, Tractor, Diesel, Gasoline, Butane, Other (Describe)

Pump Capacity (GPM)	No. of Stages	Setting Depth
		FT.

PUMP TEST

Well yielded _____ GPM with a drawdown of _____ ft. after _____ hours of pumping

RECEIVED AUG 17 1987 Department of Natural Resources Bureau of Land & Water Resources

WELL DATA

Well Depth	Casing Diameter (In.)	Casing Length (Ft.)
285'	2"	275

Type of Casing	Hole Depth	Depth to Static Water Level
Sch. 40 PVC	285	-9 ft.

TYPE OF COMPLETION: (Circle One or More): Gravel Packed, Underreamed, Telescoped, Natural Development, Open Hole, Other (Describe) Backwash & air

Top of Lap Pipe or Reduction in Casing: FEET

IF TELESCOPED OR MORE THAN ONE SCREEN: USE BACK PAGE

LOG DATA

TYPE OF LOG RUN (Circle One): Electric, Gamma Ray, Density, Sonic, Neutron, Other (Describe) No Log Run

Name of Organization Running Log

SCREEN DATA

Diameter - Inches	Length - Feet	Slot Size - Inches
2"	10	8 Slot

Screen Type	Depth to Bottom - Feet
Sch. 80 PVC	285

GEOLOGIC DATA (Office Use Only)

Surface Elev.	Geologic Unit	Unit Thickness	Depth to Top
Subs. SWL	Date	Analysis	Aquifer Test

Driller's Remarks: N/A

DESCRIPTION OF FORMATIONS ENCOUNTERED	FROM	TO	FORMATIONS (Continued)	FROM	TO
Clay	0	12			
Sd	12	47			
Clay w/shell	47	90			
Sd - Red Gravel	90	125			
Clay - Silt	125	148			
Fine Sd	148	160			
Clay - Silt	160	255			
Coarse Sd	255	285			
			IF MORE SPACE IS NEEDED, USE BACK		

If well telescopes please
sketch and show depths.

GROUND LEVEL

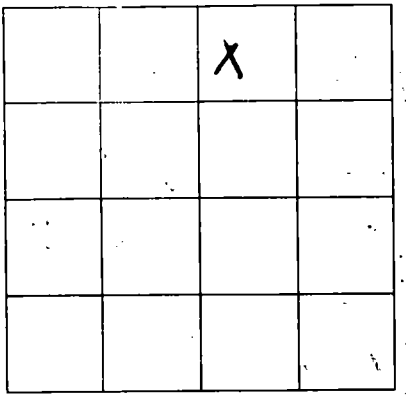

SECTION ?

Please indicate well location X.

ADDITIONAL INFORMATION

If more than one screen,
show location of each on sketch.