MISSISSIPPI DEPARTMENT OF NATURAL RESOURCES

Bureau of Land and Water Resources

P.O. Box 10631
Jackson, Mississippi 39209

WATER WELL DRILLERS LOG

COUNTY WELL LOCATED: Hancock	PERMIT NUMBER:
WELL NUMBER: K2724 CODED:	NAME OF DRILLING FIRM: Ward Well Dlg.
DATE WELL COMPLETED: Aug. 20 1987	Rt. 2, Box 350C, BSL, Ms.

NAME & MAILING ADDRESS OF LANDOWNER: May Morel, West Hinds St., Bay St. Louis Ms

WELL LOCATION: SEC 6 TOWNSHIP 9 (N/S) RANGE 14 (E/W)

DISTANCE 6 Miles DIRECTION W of NEAREST TOWN Waveland

OTHER LANDMARK: Bay Side Park Subd.

WELL PURPOSE: Home, Irrigation, Municipal, Industrial, Fish Pond, etc.: Home

PUMP DATA

PUMP TYPE (Circle One): Submersible, Turbine, Jet, Flowing Well, Other (Describe) Shallow well

POWER TYPE (Circle One): Electric, Tractor, Diesel, Gasoline, Butane, Other (Describe)

Pump Capacity (GPM)	No. of Stages	Setting Depth
10	1	30 FT.

PUMP TEST

Well yielded _____ GPM with a drawdown of _____ ft. after _____ hours of pumping

WELL DATA

Well Depth	Casing Diameter (In.)	Casing Length (Ft.)
168 ft.	2"	158 ft.

Type of Casing	Hole Depth	Depth to Static Water Level
Sch. 40 PVC	168	-15 ft.

TYPE OF COMPLETION: (Circle One or More): Gravel Packed, Underreamed, Telescoped, Natural Development, Open Hole, Other (Describe) Bradwell Screen

Top of Lap Pipe or Reduction in Casing: FEET

IF TELESCOPED OR MORE THAN ONE SCREEN: USE BACK PAGE

LOG DATA

TYPE OF LOG RUN (Circle One): No Log Run, Electric, Gamma Ray, Density, Sonic, Neutron, Other (Describe)

Name of Organization Running Log: N/A

SCREEN DATA

Diameter - Inches	Length - Feet	Slot Size - Inches
2"	10 ft.	.008 Slot

Screen Type	Depth to Bottom - Feet
Sch. 80 PVC	168

GEOLOGIC DATA (Office Use Only)

Surface Elev.	Geologic Unit	Unit Thickness	Depth to Top
Subs. SWL	Date	Analysis	Aquifer Test

Driller's Remarks: N/A

DESCRIPTION OF FORMATIONS ENCOUNTERED	FROM	TO
Clay	0	16
Sd	16	52
Clay - Shell	52	65
Clay	65	94
Sd	94	130
Clay - Silt	130	154
Sd - Red Gravel	154	168

FORMATION DESCRIPTION | FROM | TO

IF MORE SPACE IS NEEDED, USE BACK

RECEIVED
OCT 09 1987
Department of Natural Resources
Bureau of Land & Water Resources

If well telescopes please sketch and show depths.

GROUND LEVEL

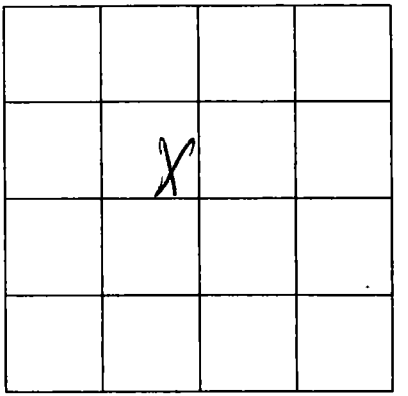

SECTION 6

Please indicate well location X.

ADDITIONAL INFORMATION

If more than one screen, show location of each on sketch.