MISSISSIPPI DEPARTMENT OF NATURAL RESOURCES

Bureau of Land and Water Resources

P.O. Box 10631
Jackson, Mississippi 39209

WATER WELL DRILLERS LOG

COUNTY WELL LOCATED: Hancock	
WELL NUMBER: R2735	CODED
DATE WELL COMPLETED: 10-9-87	
PERMIT NUMBER	
NAME OF DRILLING FIRM: Ward Well Drilling	
Rt. 2 Box 350C, B.S.L. Ms.	

NAME & MAILING ADDRESS OF LANDOWNER
Tricia Marallo
East Forest St.
Bay St. Louis, Ms.

WELL LOCATION: SEC 6 TOWNSHIP 8 (N/S) RANGE 14 (E/W)

DISTANCE 5 Miles DIRECTION W of NEAREST TOWN Waveland

OTHER LANDMARK: Bay Side Park Subdiv.

WELL PURPOSE: Home, Irrigation, Municipal, Industrial, Fish Pond, etc.
Home

PUMP DATA

PUMP TYPE (Circle One): Submersible, Turbine, Jet, Flowing Well, Other (Describe) Owner

POWER TYPE (Circle One): Electric, Tractor, Diesel, Gasoline, Butane, Other (Describe)

Pump Capacity (GPM)	No. of Stages	Setting Depth
		FT.

PUMP TEST

Well yielded _____ GPM with a drawdown of _____ ft. after _____ hours of pumping

WELL DATA

Well Depth	Casing Diameter (In.)	Casing Length (Ft.)
170 ft.	2"	160 ft.

Type of Casing	Hole Depth	Depth to Static Water Level
Sch 40 PVC	170 ft.	-12 ft.

TYPE OF COMPLETION: (Circle One or More): Gravel Packed, Underreamed, Telescoped, Natural Development, Open Hole, Other (Describe) Back Wash - air

Top of Lap Pipe or Reduction in Casing: FEET

IF TELESCOPED OR MORE THAN ONE SCREEN: USE BACK PAGE

LOG DATA

TYPE OF LOG RUN (Circle One): No Log Run; Electric, Gamma Ray, Density, Sonic, Neutron, Other (Describe)

Name of Organization Running Log

GEOLOGIC DATA (Office Use Only)

Surface Elev.	Geologic Unit	Unit Thickness	Depth to Top
Subs. SWL	Date	Analysis	Aquifer Test

Driller's Remarks
N/A

SCREEN DATA

Diameter - Inches	Length - Feet	Slot Size - Inches
2"	10 ft.	.008

Screen Type	Depth to Bottom - Feet
Sch. 80 PVC	170

DESCRIPTION OF FORMATIONS ENCOUNTERED	FROM	TO
Clay	0	14
Sd	14	47
Clay	47	96
Sd	96	132
Clay - Silt	132	148
Sd - Fine Grained	148	170

FORMATIONS (Continued)	FROM	TO

RECEIVED
DEC 17 1987
Department of Natural Resources
Bureau of Land & Water Resources

IF MORE SPACE IS NEEDED, USE BACK

If well telescopes please sketch and show depths.

GROUND LEVEL

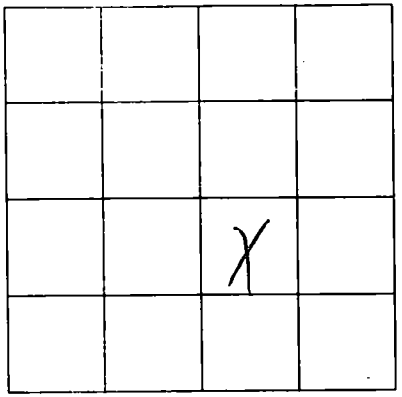

SECTION 6

Please indicate well location X.

ADDITIONAL INFORMATION

If more than one screen, show location of each on sketch.