MISSISSIPPI DEPARTMENT OF NATURAL RESOURCES

Bureau of Land and Water Resources

P.O. Box 10631
Jackson, Mississippi 39209

WATER WELL DRILLERS LOG

COUNTY WELL LOCATED: Hancock	
WELL NUMBER: R9736	CODED:
DATE WELL COMPLETED: 10-21-87	
PERMIT NUMBER:	
NAME OF DRILLING FIRM: Ward Well Drilling	
Rt. 2 Box 350C, B.S.J., Miss	

NAME & MAILING ADDRESS OF LANDOWNER
Carlton Roberts
Lower Bay Rd. Rt. 2
Bay St. Louis, Miss.

WELL LOCATION: SEC 7 TOWNSHIP 9 N (S) RANGE 14 E (W)

DISTANCE 6 Miles DIRECTION W of NEAREST TOWN Waveland

OTHER LANDMARK Lakeshore Comm.

WELL PURPOSE: Home, Irrigation, Municipal, Industrial, Fish Pond, etc.
Home

PUMP DATA

PUMP TYPE (Circle One):
Submersible, Turbine, Jet, Flowing Well, Other (Describe) Owner

POWER TYPE (Circle One):
Electric, Tractor, Diesel, Gasoline, Butane, Other (Describe)

Pump Capacity (GPM)	No. of Stages	Setting Depth
		FT.

PUMP TEST

Well yielded _____ GPM with a drawdown of _____ ft. after _____ hours of pumping

WELL DATA

Well Depth	Casing Diameter (In.)	Casing Length (Ft.)
124 ft.	2"	114 ft.

Type of Casing	Hole Depth	Depth to Static Water Level
Sch. 40 PVC	124 ft.	- 12 ft.

TYPE OF COMPLETION (Circle One or More):
Gravel Packed, Underreamed, Telescoped, Natural Development, Open Hole, Other (Describe) Back Wash - air

Top of Lap Pipe or Reduction in Casing
FEET — IF TELESCOPED OR MORE THAN ONE SCREEN: USE BACK PAGE

LOG DATA

TYPE OF LOG RUN (Circle One): No Log Run
Electric, Gamma Ray, Density, Sonic, Neutron, Other (Describe)

Name of Organization Running Log

GEOLOGIC DATA (Office Use Only)

Surface Elev.	Geologic Unit	Unit Thickness	Depth to Top
Subs. SWL	Date	Analysis	Aquifer Test

Driller's Remarks
N/A

SCREEN DATA

Diameter - Inches	Length - Feet	Slot Size - Inches
2"	10 ft.	.008

Screen Type	Depth to Bottom - Feet
Sch. 80 PVC	- 124

DESCRIPTION OF FORMATIONS ENCOUNTERED	FROM	TO	FORMATIONS (Continued)	FROM	TO
			IF MORE SPACE IS NEEDED, USE BACK		

RECEIVED
DEC 1 1 1987
Department of Natural Resources
Bureau of Land & Water Resources

If well telescopes please
sketch and show depths.

GROUND LEVEL

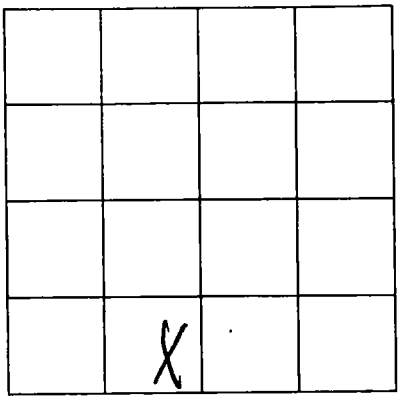

SECTION 7

Please indicate well location X.

ADDITIONAL INFORMATION

If more than one screen,
show location of each on sketch.