MISSISSIPPI DEPARTMENT OF NATURAL RESOURCES

Bureau of Land and Water Resources

P.O. Box 10631
Jackson, Mississippi 39209

WATER WELL DRILLERS LOG

COUNTY WELL LOCATED: Hancock	
WELL NUMBER: K-9741	CODED:
DATE WELL COMPLETED: 11-17-87	
PERMIT NUMBER:	
NAME OF DRILLING FIRM: Ward Well Drilling	
Rt. 2 Box 350C B.S., Ms	

NAME & MAILING ADDRESS OF LANDOWNER

David Bowman
Lower Bay Rd. - Rt. 2
Bay St. Louis, Ms.

WELL LOCATION: SEC	TOWNSHIP	RANGE
7	9 N (S)	14 E (W)

DISTANCE	DIRECTION	NEAREST TOWN
2 Miles	W	of Waveland

OTHER LANDMARK: Lakeshore Comm.

WELL PURPOSE: Home, Irrigation, Municipal, Industrial, Fish Pond, etc.: Home

PUMP DATA

PUMP TYPE (Circle One): Submersible, Turbine, Jet, Flowing Well, Other (Describe): owner

POWER TYPE (Circle One): Electric, Tractor, Diesel, Gasoline, Butane, Other (Describe):

Pump Capacity (GPM)	No. of Stages	Setting Depth
		FT.

PUMP TEST

Well yielded _____ GPM with a drawdown of _____ ft. after _____ hours of pumping

WELL DATA

Well Depth	Casing Diameter (In.)	Casing Length (Ft.)
120 ft.	2"	110 ft.

Type of Casing	Hole Depth	Depth to Static Water Level
Sch. 40 PVC	120 ft.	-12 ft.

TYPE OF COMPLETION (Circle One or More): Gravel Packed, Underreamed, Telescoped, Natural Development, Open Hole, Other (Describe): Bachuski - air

Top of Lap Pipe or Reduction in Casing: FEET

IF TELESCOPED OR MORE THAN ONE SCREEN: USE BACK PAGE

LOG DATA

TYPE OF LOG RUN (Circle One): No Log Run, Electric, Gamma Ray, Density, Sonic, Neutron, Other (Describe):

Name of Organization Running Log:

GEOLOGIC DATA (Office Use Only)

Surface Elev.	Geologic Unit	Unit Thickness	Depth to Top
Subs. SWL	Date	Analysis	Aquifer Test

Driller's Remarks: N/A

SCREEN DATA

Diameter - Inches	Length - Feet	Slot Size - Inches
2"	10 ft.	.008

Screen Type	Depth to Bottom - Feet
Sch. 80 PVC	120

DESCRIPTION OF FORMATIONS ENCOUNTERED	FROM	TO
Clay	0	10
Sd	10	42
Clay w/shell	42	92
Coarse Sd	92	120

FORMATIONS (Continued)	FROM	TO

RECEIVED DEC 17 1987 Department of Natural Resources Bureau of Land & Water Resources

IF MORE SPACE IS NEEDED, USE BACK

If well telescopes please sketch and show depths.

GROUND LEVEL

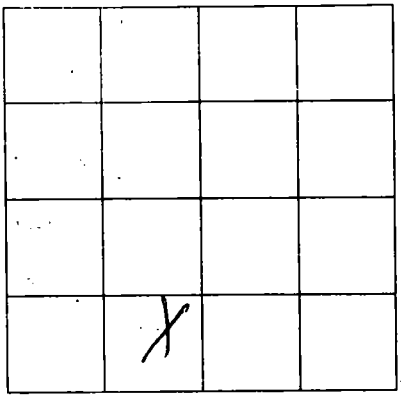

SECTION 7

Please indicate well location X.

ADDITIONAL INFORMATION

If more than one screen, show location of each on sketch.