MISSISSIPPI DEPARTMENT OF NATURAL RESOU

Bureau of Land and Water Resou

P.O. Box 1063
Jackson, Mississippi 39209
WATER WELL DRILLERS LOG

COUNTY WELL LOCATED: Hancock	PERMIT NUMBER: 0-439
WELL NUMBER: K2772 CODED	NAME OF DRILLING FIRM: Bobby Beach's Well Works
DATE WELL COMPLETED: 10-24-88	

NAME & MAILING ADDRESS OF LANDOWNER
Lucius H. Ott
P.O. Box 1327
Bay St. Louis MS

WELL LOCATION: SEC 27 TOWNSHIP 8 N S RANGE 14 E W

DISTANCE ____ Miles DIRECTION ____ of NEAREST TOWN ____

OTHER LANDMARK

WELL PURPOSE: Home, Irrigation, Municipal, Industrial, Fish Pond, etc.

PUMP DATA

PUMP TYPE (Circle One): Submersible, Turbine, Jet, Flowing Well, Other (Describe) ____

POWER TYPE (Circle One): Electric, Tractor, Diesel, Gasoline, Butane, Other (Describe) ____ H/P ____

Pump Capacity (GPM)	No. of Stages	Setting Depth
	1/2 HP	FT.

PUMP TEST

Well yielded ____ GPM with a drawdown of ____ ft. after ____ hours of pumping

WELL DATA

Well Depth	Casing Diameter (In.)	Casing Length (Ft.)
192	2"	20/172
Type of Casing	**Hole Depth**	**Depth to Static Water Level**
PVC	192	6'/n

TYPE OF COMPLETION: (Circle One or More): Gravel Packed, Underreamed, Telescoped, Natural Development, Open Hole, Other (Describe) ____

Top of Lap Pipe or Reduction in Casing FEET

IF TELESCOPED OR MORE THAN ONE SCREEN: USE BACK PAGE

LOG DATA

TYPE OF LOG RUN (Circle One): No Log Run, Electric, Gamma Ray, Density, Sonic, Neutron, Other (Describe) ____

Name of Organization Running Log: Bobby Beach

GEOLOGIC DATA (Office Use Only)

Surface Elev.	Geologic Unit	Unit Thickness	Depth to Top
Subs. SWL	Date	Analysis	Aquifer Test

Driller's Remarks: Fine Well

SCREEN DATA

Diameter - Inches	Length - Feet	Slot Size - Inches
2"	20	#8
Screen Type		**Depth to Bottom - Feet**
Johnson Screen		192

DESCRIPTION OF FORMATIONS ENCOUNTERED	FROM	TO	FORMATIONS ENCOUNTERED	FROM	TO
			IF MORE SPACE IS NEEDED, USE BACK		

RECEIVED
JUN 6 1989
Department of Natural Resources
Bureau of Land & Water Resources

If well telescopes please
sketch and show depths.

GROUND LEVEL

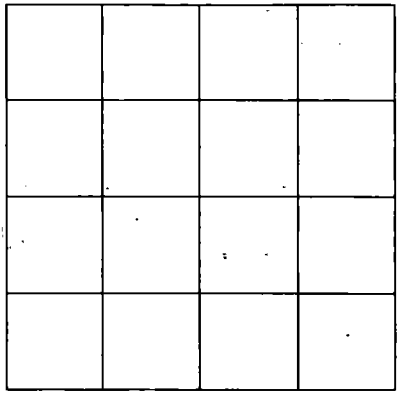

SECTION _____

Please indicate well location X.

ADDITIONAL INFORMATION

If more than one screen,
show location of each on sketch.