MISSISSIPPI DEPARTMENT OF NATURAL RESOURCES

Bureau of Land and Water Resources

P.O. Box 10631
Jackson, Mississippi 39209

WATER WELL DRILLERS LOG

COUNTY WELL LOCATED: Hancock	PERMIT NUMBER:
WELL NUMBER: K-78B	CODED:
NAME OF DRILLING FIRM: Wood Well Drlg	
DATE WELL COMPLETED: July 18, 1989	Rt. 2, Box 350C, B.S.

NAME & MAILING ADDRESS OF LANDOWNER: Elvie Yarbrough, P.O. Box 67, Lakeshore, Ms.

WELL LOCATION: SEC 13 TOWNSHIP 8 N (S) RANGE 14 E (W)

DISTANCE: 8 Miles DIRECTION: S/W of NEAREST TOWN: Waveland

OTHER LANDMARK: —

WELL PURPOSE: Home, Irrigation, Municipal, Industrial, Fish Pond, etc.: Home

PUMP DATA

PUMP TYPE (Circle One): Submersible, Turbine, Jet, Flowing Well, Other (Describe) Cuscus

POWER TYPE (Circle One): Electric, Tractor, Diesel, Gasoline, Butane, Other (Describe)

Pump Capacity (GPM)	No. of Stages	Setting Depth
		FT.

PUMP TEST

Well yielded _____ GPM with a drawdown of _____ ft. after _____ hours of pumping

WELL DATA

Well Depth	Casing Diameter (In.)	Casing Length (Ft.)
315'	2	~~315~~ 305

Type of Casing	Hole Depth	Depth to Static Water Level
Sch. 40 PVC	331'	- 11'

TYPE OF COMPLETION: (Circle One or More): Gravel Packed, Underreamed, Telescoped, Natural Development, Open Hole, Other (Describe) Backwash - air

Top of Lap Pipe or Reduction in Casing: FEET

IF TELESCOPED OR MORE THAN ONE SCREEN: USE BACK PAGE

LOG DATA

TYPE OF LOG RUN (Circle One): No Log Run, Electric, Gamma Ray, Density, Sonic, Neutron, Other (Describe)

Name of Organization Running Log

GEOLOGIC DATA (Office Use Only)

Surface Elev.	Geologic Unit	Unit Thickness	Depth to Top
Subs. SWL	Date	Analysis	Aquifer Test

Driller's Remarks: N/A

SCREEN DATA

Diameter - Inches	Length - Feet	Slot Size - Inches
2	10	.008

Screen Type	Depth to Bottom - Feet
Sch. 80 PVC	- 315

DESCRIPTION OF FORMATIONS ENCOUNTERED	FROM	TO
Clay	0	18
Clay & Sd	18	46
Clay	46	95
Sd	95	134
Clay - Sett	134	274
Coarse Sd -	274	315

FORMATIONS (Continued)	FROM	TO

RECEIVED
SEP 5 1989
Department of Natural Resources
Bureau of Land & Water Resources

IF MORE SPACE IS NEEDED, USE BACK

If well telescopes please sketch and show depths.

GROUND LEVEL

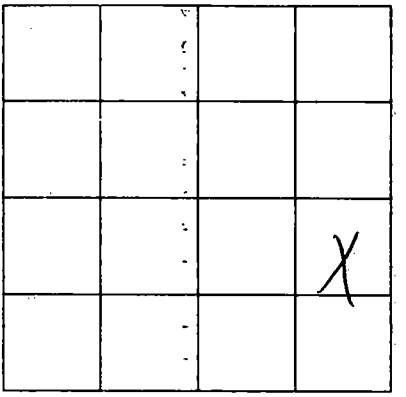

SECTION 13

Please indicate well location X.

ADDITIONAL INFORMATION

RECEIVED

If more than one screen, show location of each on sketch.