MISSISSIPPI DEPARTMENT OF NATURAL RESOURCES

Bureau of Land and Water Resources

P.O. Box 10631
Jackson, Mississippi 39209

WATER WELL DRILLERS LOG

COUNTY WELL LOCATED: Hancock	PERMIT NUMBER:
WELL NUMBER: K2789 CODED:	NAME OF DRILLING FIRM: Ward Well Drlg.
DATE WELL COMPLETED: 5-1-89	Rt. 2 Box 350C, B.S.L.

NAME & MAILING ADDRESS OF LANDOWNER: Mrs. N. Andrus, South Beach Dr., Ladeshoe, Ms.

WELL LOCATION: SEC ? TOWNSHIP 9 N (S) RANGE 14 E (W)

DISTANCE: 10 Miles DIRECTION: S/W of NEAREST TOWN: Waveland

OTHER LANDMARK:

WELL PURPOSE: Home, Irrigation, Municipal, Industrial, Fish Pond, etc.: Home

PUMP DATA

PUMP TYPE (Circle One): Submersible, Turbine, Jet, Flowing Well, Other (Describe) Cirmen

POWER TYPE (Circle One): Electric, Tractor, Diesel, Gasoline, Butane, Other (Describe)

Pump Capacity (GPM)	No. of Stages	Setting Depth
		FT.

PUMP TEST

Well yielded _____ GPM with a drawdown of _____ ft. after _____ hours of pumping

WELL DATA

Well Depth	Casing Diameter (In.)	Casing Length (Ft.)
336'	2	326

Type of Casing	Hole Depth	Depth to Static Water Level
Sch. 40 PVC	336'	-3 ft.

TYPE OF COMPLETION: (Circle One or More): Gravel Packed, Underreamed, Telescoped, Natural Development, Open Hole, (Other) (Describe) Backwash - air

Top of Lap Pipe or Reduction in Casing: FEET

IF TELESCOPED OR MORE THAN ONE SCREEN: USE BACK PAGE

LOG DATA

TYPE OF LOG RUN (Circle One): (No Log Run) Electric, Gamma Ray, Density, Sonic, Neutron, Other (Describe)

Name of Organization Running Log

GEOLOGIC DATA (Office Use Only)

Surface Elev.	Geologic Unit	Unit Thickness	Depth to Top
Subs. SWL	Date	Analysis	Aquifer Test

SCREEN DATA

Diameter - Inches	Length - Feet	Slot Size - Inches
2"	10	.008

Screen Type	Depth to Bottom - Feet
Sch. 80 PVC	-336

Driller's Remarks: No Sec. # on map.-

	18	17
24	9	
	30	

DESCRIPTION OF FORMATIONS ENCOUNTERED	FROM	TO
Fill - Clay	0	15
Sd.	15	45
Clay	45	112
Sd.	112	121
Clay - Silt	121	284
Coarse Sd. - Pea Gravel	284	336

FORMATIONS (Continued)	FROM	TO

RECEIVED
SEP 5 1989
Department of Natural Resources
Bureau of Land & Water Resources

IF MORE SPACE IS NEEDED, USE BACK

If well telescopes please
sketch and show depths.

GROUND LEVEL

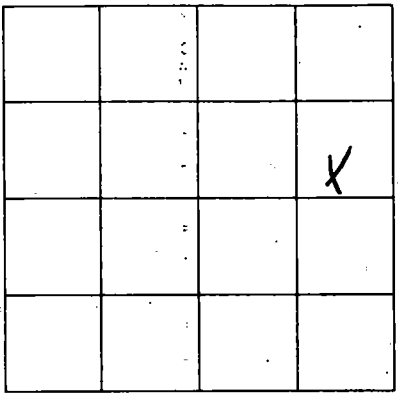

SECTION ?

Please indicate well location X.

ADDITIONAL INFORMATION

If more than one screen,
show location of each on sketch.