MISSISSIPPI DEPARTMENT OF NATURAL RESOURCES

Bureau of Land and Water Resources

P.O. Box 10631
Jackson, Mississippi 39209

WATER WELL DRILLERS LOG

COUNTY WELL LOCATED: Hancock	
WELL NUMBER: R-2793	CODED:
DATE WELL COMPLETED: Aug 11, 1989	
PERMIT NUMBER:	
NAME OF DRILLING FIRM: WARD WELL DLG. RT.2, BX.350, B.S L	

NAME & MAILING ADDRESS OF LANDOWNER:
DON NEPAISE
JORDOL RIVER EST,
KILN, MS

WELL LOCATION: SEC 31 TOWNSHIP 8 N (S) RANGE 14 E (W)

DISTANCE 8 Miles DIRECTION N of NEAREST TOWN KILN

OTHER LANDMARK: JORDON RIVER EST,

WELL PURPOSE: Home, Irrigation, Municipal, Industrial, Fish Pond, etc.
HOME

PUMP DATA

PUMP TYPE (Circle One): Submersible, Turbine, (Jet) Flowing Well, Other (Describe) _____

POWER TYPE (Circle One): (Electric) Tractor, Diesel, Gasoline, Butane, Other (Describe) _____

Pump Capacity (GPM)	No. of Stages	Setting Depth
12	2	FT.

PUMP TEST

Well yielded _____ GPM with a drawdown of _____ ft. after _____ hours of pumping

WELL DATA

Well Depth	Casing Diameter (In.)	Casing Length (Ft.)
463'	2	453

Type of Casing	Hole Depth	Depth to Static Water Level
SCH. 40 PVC	463	-30'

TYPE OF COMPLETION: (Circle One or More): Gravel Packed, Underreamed, Telescoped, Natural Development, Open Hole, (Other) (Describe) Backwash - air

Top of Lap Pipe or Reduction in Casing: FEET

IF TELESCOPED OR MORE THAN ONE SCREEN: USE BACK PAGE

LOG DATA

TYPE OF LOG RUN (Circle One): (No Log Run) Electric, Gamma Ray, Density, Sonic, Neutron, Other (Describe) _____

Name of Organization Running Log: '

GEOLOGIC DATA (Office Use Only)

Surface Elev.	Geologic Unit	Unit Thickness	Depth to Top
Subs. SWL	Date	Analysis	Aquifer Test

Driller's Remarks: N/A

SCREEN DATA

Diameter - Inches	Length - Feet	Slot Size - Inches
2"	10	.008

Screen Type	Depth to Bottom - Feet
SCH. 80 PVC	-463

DESCRIPTION OF FORMATIONS ENCOUNTERED	FROM	TO
CLAY	0	22
Sdy CLAY	22	70
FINE Sd	70	86
CLAY SILT	86	420
CORSE Sd	420	463

FORMATIONS (continued)	FROM	TO

RECEIVED
DEC 0 1989
Department of Natural Resources
Bureau of Land & Water Resources

IF MORE SPACE IS NEEDED, USE BACK

If well telescopes please sketch and show depths.

GROUND LEVEL

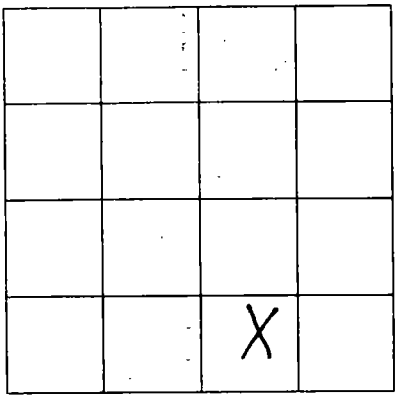

SECTION 31

Please indicate well location X.

ADDITIONAL INFORMATION

If more than one screen, show location of each on sketch.