MISSISSIPPI DEPARTMENT OF NATURAL RESOURCES

Bureau of Land and Water Resources

P.O. Box 10631
Jackson, Mississippi 39209

WATER WELL DRILLERS LOG

COUNTY WELL LOCATED: HANCOCK	PERMIT NUMBER:
WELL NUMBER: K2794 CODED:	NAME OF DRILLING FIRM: WARD WELL DLG.
DATE WELL COMPLETED: SEPT. 1, 1989	RT.2, BX.350C, B.S.L, MS

NAME & MAILING ADDRESS OF LANDOWNER
JANET HITT
SUGARFIELD Rd.
BAY ST. LOUIS, MS.

WELL LOCATION: SEC 40 TOWNSHIP 8 N (S) RANGE 14 E (W)

DISTANCE 5 Miles DIRECTION N of NEAREST TOWN WAVELAND

OTHER LANDMARK

WELL PURPOSE: Home, Irrigation, Municipal, Industrial, Fish Pond, etc.
HOME

PUMP DATA

PUMP TYPE (Circle One): Submersible, Turbine, (Jet) Flowing Well, Other (Describe) _____

POWER TYPE (Circle One): Electric, Tractor, Diesel, Gasoline, Butane, Other (Describe) _____

Pump Capacity (GPM)	No. of Stages	Setting Depth
18	1	FT.

PUMP TEST

Well yielded _____ GPM with a drawdown of _____ ft. after _____ hours of pumping

WELL DATA

Well Depth	Casing Diameter (In.)	Casing Length (Ft.)
170'	[redacted]' 2"	160'

Type of Casing	Hole Depth	Depth to Static Water Level
PVC	170'	-8'

TYPE OF COMPLETION: (Circle One or More): Gravel Packed, Underreamed, Telescoped, Natural Development, Open Hole, (Other)
(Describe) BACKWASH - AIR

Top of Lap Pipe or Reduction in Casing
FEET

IF TELESCOPED OR MORE THAN ONE SCREEN: USE BACK PAGE

LOG DATA

TYPE OF LOG RUN (Circle One): (No Log Run) Electric, Gamma Ray, Density, Sonic, Neutron, Other (Describe) _____

Name of Organization Running Log

GEOLOGIC DATA (Office Use Only)

Surface Elev.	Geologic Unit	Unit Thickness	Depth to Top
Subs. SWL	Date	Analysis	Aquifer Test

Driller's Remarks
N/A

SCREEN DATA

Diameter - Inches	Length - Feet	Slot Size - Inches
2	10	.008

Screen Type	Depth to Bottom - Feet
SCH. 80 PVC	170

RECEIVED
DEC 05 1989
Department of Natural Resources
Bureau of Land & Water Resources

DESCRIPTION OF FORMATIONS ENCOUNTERED	FROM	TO
CLAY	0	15
SD	15	46
CLAY	46	95
FINE SD	95	117
CLAY - SILT	117	154
SD	154	170

FORMATIONS (Continued)	FROM	TO

IF MORE SPACE IS NEEDED, USE BACK

If well telescopes please sketch and show depths.

GROUND LEVEL

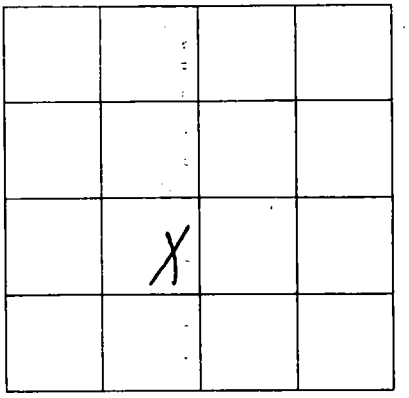

SECTION 40

Please indicate well location X.

ADDITIONAL INFORMATION

If more than one screen, show location of each on sketch.