MISSISSIPPI DEPARTMENT OF NATURAL RESOURCES

Bureau of Land and Water Resources

P.O. Box 10631
Jackson, Mississippi 39209

WATER WELL DRILLERS LOG

COUNTY WELL LOCATED: Hancock	PERMIT NUMBER:
WELL NUMBER: R2883 CODED:	NAME OF DRILLING FIRM: Ward Well Drilling
DATE WELL COMPLETED: June 7, 1990	6192 Sowell Bay Rd. B.S.L.

NAME & MAILING ADDRESS OF LANDOWNER: Mrs. Quida Williams, Hancock Dr., Bay St. Louis, Ms.

WELL LOCATION: SEC 6 TOWNSHIP 9 N (S) RANGE 14 E (W)

DISTANCE 4 Miles DIRECTION W of NEAREST TOWN Waveland

OTHER LANDMARK: Bay Side Park Subd.

WELL PURPOSE: Home, Irrigation, Municipal, Industrial, Fish Pond, etc.: Home

PUMP DATA

PUMP TYPE (Circle One): Submersible, Turbine, Jet, Flowing Well, Other (Describe) Shallow well jet

POWER TYPE (Circle One): (Electric), Tractor, Diesel, Gasoline, Butane, Other (Describe) _____

Pump Capacity (GPM)	No. of Stages	Setting Depth
10	1	FT.

PUMP TEST

Well yielded _____ GPM with a drawdown of _____ ft. after _____ hours of pumping

WELL DATA

Well Depth	Casing Diameter (In.)	Casing Length (Ft.)
168'	2	158'

Type of Casing	Hole Depth	Depth to Static Water Level
Sch. 40 PVC	168'	-12'

TYPE OF COMPLETION: (Circle One or More): Gravel Packed, Underreamed, Telescoped, Natural Development, Open Hole, Other (Describe) Backwash - air

Top of Lap Pipe or Reduction in Casing: FEET

IF TELESCOPED OR MORE THAN ONE SCREEN: USE BACK PAGE

LOG DATA

TYPE OF LOG RUN (Circle One): (No Log Run), Electric, Gamma Ray, Density, Sonic, Neutron, Other (Describe) _____

Name of Organization Running Log

GEOLOGIC DATA (Office Use Only)

Surface Elev.	Geologic Unit	Unit Thickness	Depth to Top
Subs. SWL	Date	Analysis	Aquifer Test

Driller's Remarks: Replacement well. - old well capped.

SCREEN DATA

Diameter - Inches	Length - Feet	Slot Size - Inches
2	10	.008

Screen Type	Depth to Bottom - Feet
Sch. 80 PVC	-168

DESCRIPTION OF FORMATIONS ENCOUNTERED	FROM	TO	FORMATIONS ENCOUNTERED	FROM	TO
Clay	0	13			
Sd	13	45			
Clay	45	96			
Sd	96	128			
Clay	128	152			
Red Gravel - Sd.	152	168			
			IF MORE SPACE IS NEEDED, USE BACK		

RECEIVED
AUG 22 1990
Department of Natural Resources
Bureau of Land & Water Resources

If well telescopes please sketch and show depths.

GROUND LEVEL

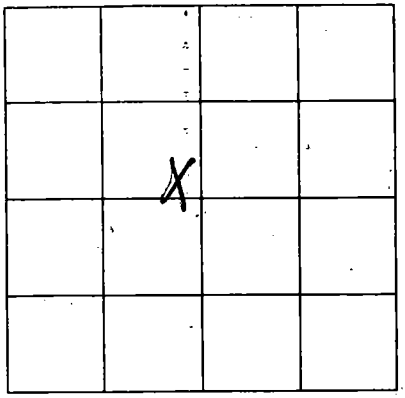

SECTION 6

Please indicate well location X.

ADDITIONAL INFORMATION

If more than one screen, show location of each on sketch.