MISSISSIPPI DEPARTMENT OF NATURAL RESOURCES

Bureau of Land and Water Resources

P.O. Box 10631
Jackson, Mississippi 39209

WATER WELL DRILLERS LOG

COUNTY WELL LOCATED: Hancock	PERMIT NUMBER:
WELL NUMBER: K2831	CODED:
DATE WELL COMPLETED: 11-14-90	NAME OF DRILLING FIRM: Ward Well Drilling, 6192 Sonner Bay Rd, B.S.J.

NAME & MAILING ADDRESS OF LANDOWNER
Bill Seay
1 Helen St.
Bay St. Louis Ms.

WELL LOCATION: SEC 22 TOWNSHIP 8 (N) (S) RANGE 14 (E) (W)

DISTANCE 3 Miles **DIRECTION** N/W **NEAREST TOWN** of B.S.J.

OTHER LANDMARK Jordan River Dale Sub

WELL PURPOSE: Home, Irrigation, Municipal, Industrial, Fish Pond, etc.
Home

PUMP DATA

PUMP TYPE (Circle One): Submersible, Turbine, Jet, Flowing Well, Other (Describe) Owner

POWER TYPE (Circle One): Electric, Tractor, Diesel, Gasoline, Butane, Other (Describe)

Pump Capacity (GPM)	No. of Stages	Setting Depth
		FT.

PUMP TEST

Well yielded _____ GPM with a drawdown of _____ ft. after _____ hours of pumping

WELL DATA

Well Depth	Casing Diameter (In.)	Casing Length (Ft.)
540'	2	520

Type of Casing	Hole Depth	Depth to Static Water Level
Sch. 40 PVC	540'	+5 ✓

TYPE OF COMPLETION: (Circle One or More): Gravel Packed, Underreamed, Telescoped, Natural Development, Open Hole, Other (Describe) Backwash - air

Top of Lap Pipe or Reduction in Casing FEET

IF TELESCOPED OR MORE THAN ONE SCREEN: USE BACK PAGE

LOG DATA

TYPE OF LOG RUN (Circle One): Electric, Gamma Ray, Density, Sonic, Neutron, Other (Describe) No Log Run

Name of Organization Running Log

GEOLOGIC DATA (Office Use Only)

Surface Elev.	Geologic Unit	Unit Thickness	Depth to Top
Subs. SWL	Date	Analysis	Aquifer Test

Driller's Remarks
N/A

SCREEN DATA

Diameter - Inches	Length - Feet	Slot Size - Inches
2	20	.008

Screen Type	Depth to Bottom - Feet
Sch. 80 PVC	- 540

DESCRIPTION OF FORMATIONS ENCOUNTERED	FROM	TO
Clay	0	18
Sd.	18	46
Clay - Silt	46	150
Fine Sd.	150	178
Clay - Silt	178	276
Sd.	276	290
Clay - Silt	290	365
Sd.	365	415
Clay - Silt	415	504
Coarse Sd.	504	540

FORMATIONS (Continued)	FROM	TO

RECEIVED
JAN 30 1991
Dept. of Environmental Quality
Bureau of Land & Water Resources

IF MORE SPACE IS NEEDED, USE BACK

If well telescopes please
sketch and show depths.

GROUND LEVEL

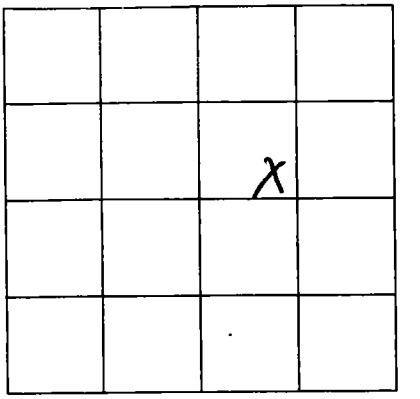

SECTION 22

Please indicate well location X.

ADDITIONAL INFORMATION

If more than one screen,
show location of each on sketch.