

MISSISSIPPI DEPARTMENT OF ENVIRONMENTAL QUALITY
Office of Land and Water Resources

P. O. Box 10631
Jackson, MS 39289-0631
WATER WELL DRILLERS LOG

COUNTY WELL LOCATED Hancock	
WELL NUMBER R 2881	CODED
DATE WELL COMPLETED 10-12-93	

PERMIT NUMBER 0-477
NAME OF DRILLING FIRM Penton Well Service Nicholson, Ms.

NAME & MAILING ADDRESS OF LANDOWNER Richard St. Pe'			
2188 Mole Dr.			
Bay St. Louis, MS.			
WELL LOCATION:	SEC	TOWNSHIP	RANGE
	27	8 S	14 W
DISTANCE	DIRECTION	NEAREST TOWN	
2 Miles	N.E.	Bay St. Louis	
OTHER LANDMARK 1 mile from Hospital HANCOCK CO.			
WELL PURPOSE: Home Irrigation, Municipal, Industrial, Fish Pond, etc. Home			

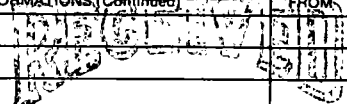
PUMP DATA		
PUMP TYPE (Circle One): Submersible, Turbine, Jet , Flowing Well Other (Describe) _____		
POWER TYPE (Circle One): Electric , Tractor, Diesel, Gasoline, Butane, Other (Describe) _____ H/P _____		
Pump Capacity (GPM)	No. of Stages	Setting Depth
		FT.
PUMP TEST		
Well yielded _____ GPM with a drawdown of _____ ft. after _____ hours of pumping		

WELL DATA		
Well Depth 575'	Casing Diameter (In.) 2"	Casing Length (Ft.) 565'
Type of Casing PVC	Hole Depth 575'	Depth to Static Water Level Flow
TYPE OF COMPLETION: (Circle One or More): Natural Development , Underreamed, Telescoped, Open Hole, Other		
WELL GROUTED TO A DEPTH OF 10 FEET Type Grout (circle one): Cement , Bentonite, or Mix		

LOG DATA	
TYPE OF LOG RUN (Circle One): Electric, Gamma Ray, Density, Sonic, Neutron, Other (Describe) _____	
Name of Organization Running Log	

SCREEN DATA		
Diameter - Inches 2	Length - Feet 10	Slot Size - Inches 10
Screen Type PVC	Depth to Bottom - Feet 565-575	

GEOLOGIC DATA (Office Use Only)			
Surface Elev.	Geologic Unit	Unit Thickness	Depth to Top
Subs. SWL	Date	Analysis	Aquifer Test
Driller's Remarks			

DESCRIPTION OF FORMATIONS ENCOUNTERED	FROM	TO	FORMATIONS (Continued)	FROM	TO
clay	0	30	 NOV 09 1993 Dept. of Environmental Quality Office of Land & Water Resources		
sand	30	55			
clay	55	190			
silt	190	205			
clay	205	370			
sand	370	410			
clay	410	500			
sand	500	575			

IF MORE SPACE IS NEEDED, USE BACK

