MISSISSIPPI DEPARTMENT OF ENVIRONMENTAL QUALITY
Office of Land and Water Resources

P. O. Box 10631
Jackson, MS 39289-0631
WATER WELL DRILLERS LOG

COUNTY WELL LOCATED: Hancock	PERMIT NUMBER: 0239
WELL NUMBER: K2893 CODED	NAME OF DRILLING FIRM: McGill Pump & Well
DATE WELL COMPLETED: 8-7-95	

NAME & MAILING ADDRESS OF LANDOWNER
Kurt Raymond
513 Cadillac dr.
Bay St Louis Ms. 39520

WELL LOCATION	SEC	TOWNSHIP	RANGE
37	26	9	14 (N/S) (E/W)

DISTANCE	DIRECTION	NEAREST TOWN
1 Miles	NORTH of	B.S.L.

OTHER LANDMARK: off Washington

WELL PURPOSE: Home, Irrigation, Municipal, Industrial, Fish Pond, etc.

PUMP DATA

PUMP TYPE (Circle One): Submersible, Turbine, Jet, Flowing Well, Other (Describe) _____

POWER TYPE (Circle One): Electric, Tractor, Diesel, Gasoline, Butane, Other (Describe) _____ H/P 2

Pump Capacity (GPM)	No. of Stages	Setting Depth
24	3	60' FT.

PUMP TEST
Well yielded 24 GPM with a drawdown of 10 ft. after 12 hours of pumping

WELL DATA

Well Depth	Casing Diameter (In.)	Casing Length (Ft.)
540'	2"	520'

Type of Casing	Hole Depth	Depth to Static Water Level
PVC	540'	30'

TYPE OF COMPLETION: (Circle One or More): Gravel Packed, Underreamed, Telescoped, Natural Development, Open Hole, Other (Describe) _____

WELL GROUTED TO A DEPTH OF 10 FEET
Type Grout (circle one): Cement, Bentonite, or Mix

LOG DATA

TYPE OF LOG RUN (Circle One): No Log Run, Electric, Gamma Ray, Density, Sonic, Neutron, Other (Describe) _____

Name of Organization Running Log

GEOLOGIC DATA (Office Use Only)

Surface Elev.	Geologic Unit	Unit Thickness	Depth to Top
Subs. SWL	Date	Analysis	Aquifer Test

Driller's Remarks

SCREEN DATA

Diameter - Inches	Length - Feet	Slot Size - Inches
2"	20'	.0006

Screen Type	Depth to Bottom - Feet
PVC	540

Top of Lap Pipe or Reduction in Casing
FEET — IF TELESCOPED OR MORE THAN ONE SCREEN: USE BACK PAGE

DESCRIPTION OF FORMATIONS ENCOUNTERED	FROM	TO	FORMATIONS (Continued)	FROM	TO
mud/sand	0	70			
mud	70	160			
sand	160	180			
mud	180	350			
sand	350	410			
mud	410	495			
sand	495	540			
			IF MORE SPACE IS NEEDED, USE BACK		

RECEIVED
NOV 07 1995
Dept. of Environmental Quality
Office of Land & Water Resources

If well telescopes please sketch and show depths.

GROUND LEVEL

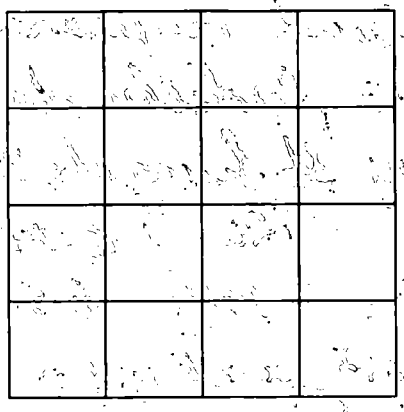

SECTION _____

Please indicate well location X.

ADDITIONAL INFORMATION

If more than one screen, show location of each on sketch.