MISSISSIPPI DEPARTMENT OF ENVIRONMENTAL QUALITY
Office of Land and Water Resources

P. O. Box 10631
Jackson, MS 39289-0631

WATER WELL DRILLERS LOG

COUNTY WELL LOCATED	HANCOCK
WELL NUMBER	K-2937
CODED	
DATE WELL COMPLETED	5-7-01
PERMIT NUMBER	
NAME OF DRILLING FIRM	NECHASE WELL SERVICE

NAME & MAILING ADDRESS OF LANDOWNER
CORR CONST.
BEVERLY / CHAPMAN
BAY ST. LOUIS MS 39520

WELL LOCATION	SEC	TOWNSHIP	RANGE
	28	8 N (S)	14 E (W)

DISTANCE	DIRECTION	NEAREST TOWN
1 1/2 Miles	W	of BAY ST. LOUIS

OTHER LANDMARK

WELL PURPOSE: (Home) Irrigation, Municipal, Industrial, Fish Pond, etc.

PUMP DATA

PUMP TYPE (Circle One):
Submersible, Turbine, Jet Flowing Well,
Other (Describe) _____

POWER TYPE (Circle One):
Electric, Tractor, Diesel, Gasoline, Butane,
Other (Describe) _____ H/P _____

Pump Capacity (GPM)	No. of Stages	Setting Depth
		FT.

PUMP TEST

Well yielded _____ GPM with

a drawdown of _____ ft.

after _____ hours of pumping

WELL DATA

Well Depth	Casing Diameter (In.)	Casing Length (Ft.)
170	2	160

Type of Casing	Hole Depth	Depth to Static Water Level
PVC	170	10

TYPE OF COMPLETION: (Circle One or More):
Gravel Packed, Underreamed, Telescoped,
Natural Development, Open Hole, Other
(Describe) _____

WELL GROUTED TO A DEPTH OF 12 FEET
Type Grout (circle one): Cement, Bentonite, (Mix)

LOG DATA

TYPE OF LOG RUN (Circle One): No Log Run,
Electric, Gamma Ray, Density, Sonic, Neutron,
Other (Describe) _____

Name of Organization Running Log

GEOLOGIC DATA (Office Use Only)

Surface Elev.	Geologic Unit	Unit Thickness	Depth to Top
Subs. SWL	Date	Analysis	Aquifer Test

Driller's Remarks
WELL ONLY

Top of Lap Pipe or Reduction in Casing
FEET

IF TELESCOPED OR MORE THAN ONE SCREEN: USE BACK PAGE

SCREEN DATA

Diameter - Inches	Length - Feet	Slot Size - Inches
2	10	.006

Screen Type	Depth to Bottom - Feet
PVC	170

DESCRIPTION OF FORMATIONS ENCOUNTERED	FROM	TO
MUD	0	20
SAND	20	50
CLAY	50	120
SAND	120	170

FORMATIONS (Continued)	FROM	TO

REC'D JUL 02 2001

IF MORE SPACE IS NEEDED, USE BACK

If well telescopes please sketch and show depths.

GROUND LEVEL

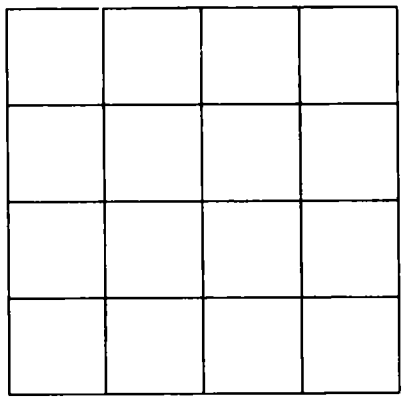

SECTION _____

Please indicate well location X.

ADDITIONAL INFORMATION

If more than one screen, show location of each on sketch.