MISSISSIPPI DEPARTMENT OF ENVIRONMENTAL QUALITY
Office of Land and Water Resources

P. O. Box 10631
Jackson, MS 39289-0631
WATER WELL DRILLERS LOG

COUNTY WELL LOCATED: HANCOCK	
WELL NUMBER: 3	CODED:
K-2946	PERMIT NUMBER: 0-493
DATE WELL COMPLETED: 8/31/00	NAME OF DRILLING FIRM: BEECH WELL WORKS

NAME & MAILING ADDRESS OF LANDOWNER
ROBERT E.
7075 MEADOW DALE
BILOXI. MS 39576

WELL LOCATION	SEC	TOWNSHIP	RANGE
	33	8 N (S)	14 E (W)

DISTANCE	DIRECTION	NEAREST TOWN
_____ Miles	_____ of	_____

OTHER LANDMARK

WELL PURPOSE: (Home) Irrigation, Municipal, Industrial, Fish Pond, etc.

PUMP DATA

PUMP TYPE (Circle One): Submersible, Turbine, (Jet) Flowing Well, Other (Describe) _____

POWER TYPE (Circle One): (Electric) Tractor, Diesel, Gasoline, Butane, Other (Describe) _____ H/P _____

Pump Capacity (GPM)	No. of Stages	Setting Depth
14	2	40 FT.

PUMP TEST

Well yielded _____ GPM with a drawdown of _____ ft. after _____ hours of pumping

WELL DATA

Well Depth	Casing Diameter (In.)	Casing Length (Ft.)
180	2	160

Type of Casing	Hole Depth	Depth to Static Water Level
PVC	180	15

TYPE OF COMPLETION: (Circle One or More): Gravel Packed, Underreamed, Telescoped, (Natural Development) Open Hole, Other (Describe) _____

WELL GROUTED TO A DEPTH OF 10 FEET
Type Grout (circle one): (Cement) Bentonite, or Mix

LOG DATA

TYPE OF LOG RUN (Circle One): (No Log Run) Electric, Gamma Ray, Density, Sonic, Neutron, Other (Describe) _____

Name of Organization Running Log

GEOLOGIC DATA (Office Use Only)

Surface Elev.	Geologic Unit	Unit Thickness	Depth to Top
Subs. SWL	Date	Analysis	Aquifer Test

Driller's Remarks

Top of Lap Pipe or Reduction in Casing
FEET — IF TELESCOPED OR MORE THAN ONE SCREEN: USE BACK PAGE

SCREEN DATA

Diameter - Inches	Length - Feet	Slot Size - Inches
2	20	.006

Screen Type	Depth to Bottom - Feet
PVC	

DESCRIPTION OF FORMATIONS ENCOUNTERED	FROM	TO
MUD	0	16
SAND	16	84
MUD	84	120
FINE SAND	120	145
MUD	145	160
GREEN SAND	160	180

FORMATIONS (Continued)	FROM	TO

REC'D MAY 08 2001

IF MORE SPACE IS NEEDED, USE BACK

If well telescopes please
sketch and show depths.

GROUND LEVEL

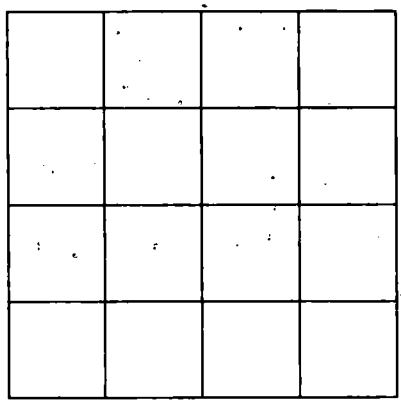

SECTION _____

Please indicate well location X.

ADDITIONAL INFORMATION

If more than one screen,
show location of each on sketch.